


Section 31 Township 27 Range 4W

Well No. #2 Davis

Company Westgate-Greenland

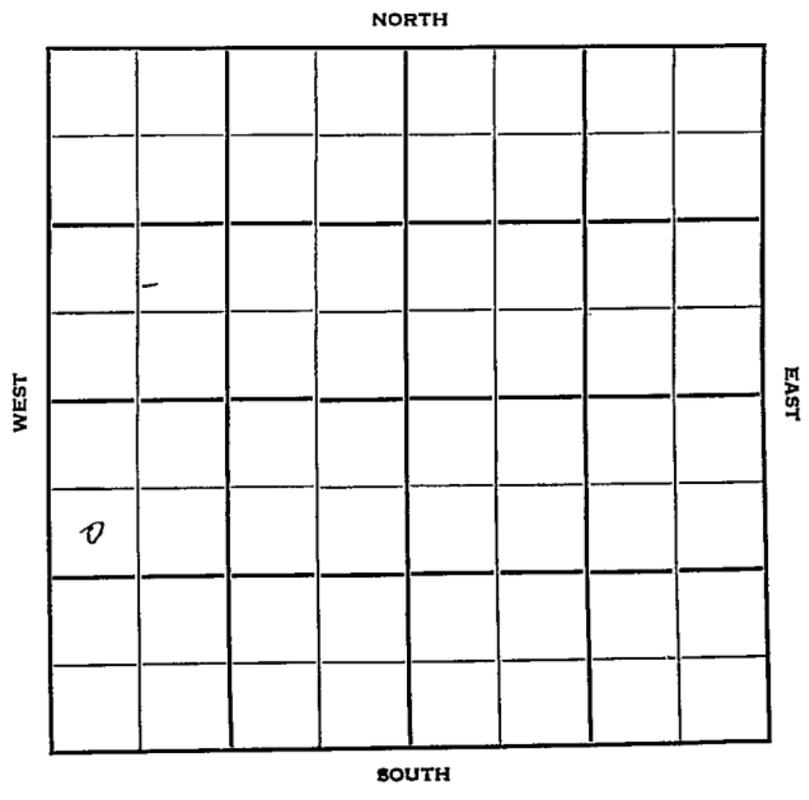

Sedgwick

KANSAS

Sec. 31 Twp 27 R. 4W

Well No. #2 Davis Farm

Westgate-Greenland Company

Jackson Drlg. Contractor

Bartholomew Pool


990' Ft. from N. Line

Ft. from S. Line

Ft. from E. Line

330' Ft. from W. Line

SW NW SW

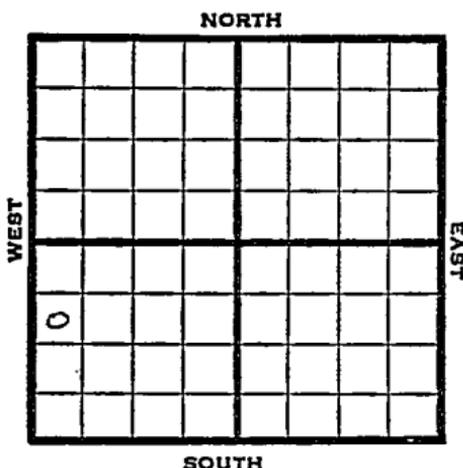

1950 Elev. 1422' REPORT

4/12 9-5/8" @ 189'  
Drlg. 1235'

5/17 TD 3763  
8 5/8 @ 189  
Miss 3716  
5" @ 3758  
Clean out to 3763 TD  
1920 BOPD  
Completed

**COMPLETED**

Kansas

Map No. \_\_\_\_\_ Sec. 31 Twp. 27 R. 4WWell No. 2 Davis\_\_\_\_\_ Westgate-Greenland \_\_\_\_\_ Company\_\_\_\_\_ Jackson Drlg. \_\_\_\_\_ Contractor

E1. 1422

SW NW SW

## SECTION PLAT

990 Ft. from N. Line

\_\_\_\_\_ Ft. from S. Line

\_\_\_\_\_ Ft. from E. Line

330 Ft. from W. Line

Sedgwick County

Location \_\_\_\_\_

Rig up \_\_\_\_\_

Drilling and Remarks:

9 5/8" @ 189

drlg. 1235

## RECORD

Cased \_\_\_\_\_ in., \_\_\_\_\_ ft.

Sand \_\_\_\_\_

Gas \_\_\_\_\_

Oil \_\_\_\_\_

Total Depth \_\_\_\_\_

## PRODUCTION

1st 24 hrs. Nat. \_\_\_\_\_

1st 24 hrs. after shot \_\_\_\_\_

Gas \_\_\_\_\_ Cu. Ft.

Dry Hole \_\_\_\_\_

Abandoned \_\_\_\_\_

Date

APR 12 1950 19 J. E. TYRA Scout

Map No. \_\_\_\_\_ Sec. 31 Twp. 27 R. 4W

Well No. 2 Davis

Westgate-Greenland Company

Contractor

E1. 1422

**SECTION PLAT**

S<sup>11</sup> NW SW

090 Ft. from N. Line

\_\_\_\_\_ Ft. from S. Line

\_\_\_\_\_ Ft. from E. Line

330 Ft. from W. Line

o			
	<b>COMPLETE</b>		

Sedgwick

Location \_\_\_\_\_

Rig up \_\_\_\_\_

Drilling and Remarks:

*8 5/8 @ 189*  
*min 3716*  
*5" @ 3758*  
*Clean out to*  
*3763 T-D.*  
*1920 BOPD*

**RECORD**

Cased \_\_\_\_\_ in., \_\_\_\_\_ ft.

Sand \_\_\_\_\_

Gas \_\_\_\_\_

Oil \_\_\_\_\_

Total Depth 3763

**PRODUCTION**

1st 24 hrs. Nat. \_\_\_\_\_

1st 24 hrs. after shot \_\_\_\_\_

Gas \_\_\_\_\_ Cu. Ft.

Dry Hole \_\_\_\_\_

Abandoned \_\_\_\_\_

Date

MAY 17 1950

19

**J. E. TYRA** Scout