


Section 31 Township 27 Range 4W

Well No. #3 Davis

Company Westgate-Greenland

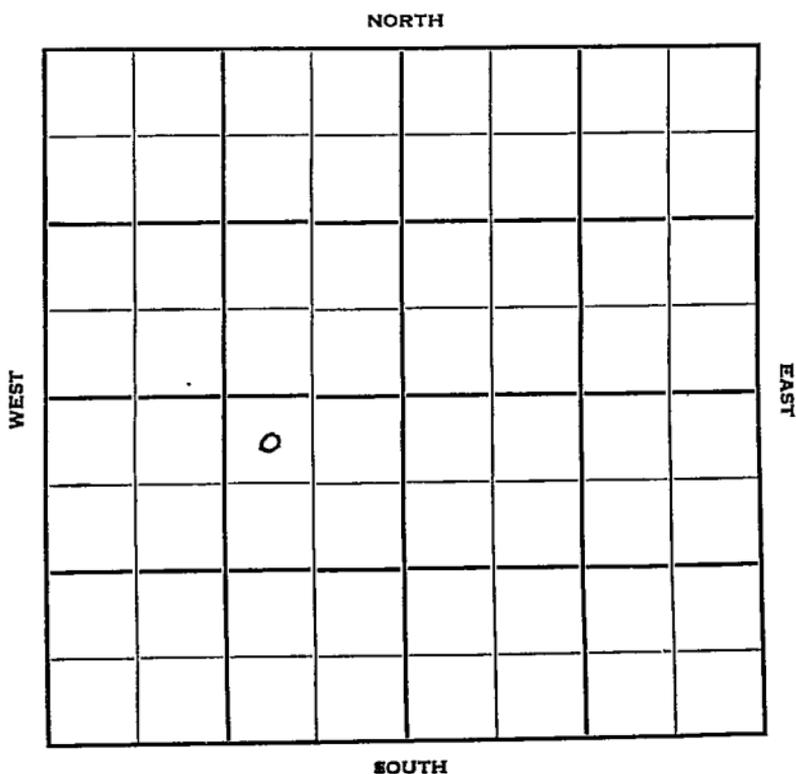

Sec. 31 Twp. 27 R. 4W

Well No. #3 Davis Farm

Westgate-Greenland Company

Contractor


330' Ft. from N. Line

\_\_\_\_\_ Ft. from S. Line

990' Ft. from E. Line

\_\_\_\_\_ Ft. from W. Line

NW NE SW

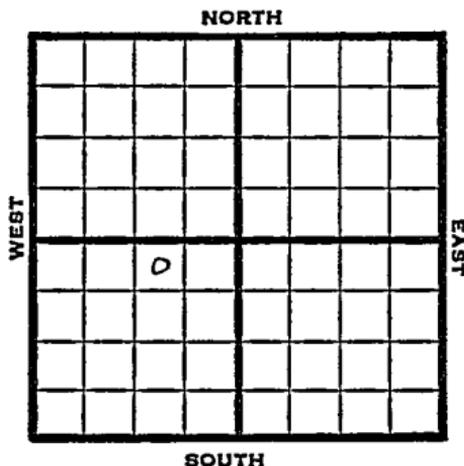

1950

Elev 1406

REPORT

4/26

Spud 4-21-50  
10-3/4" @ 210'  
Drlg. 2020'

5/24

TD 3744  
10 3/4" @ 210  
Miss 3710-44  
5" @ 3730  
1000 acid  
Comp 412 bopd 4% wtr  
Completed

**COMPLETED**

20823

Map No. \_\_\_\_\_ Sec. 31 Twp. 27 R. 4W

Well No. 3 Davis

Westgate-Greenland Company

Contractor

NW NE SW

**SECTION PLAT**

330 Ft. from N. Line

\_\_\_\_\_ Ft. from S. Line

990 Ft. from E. Line

\_\_\_\_\_ Ft. from W. Line



Sedgwick County

Location \_\_\_\_\_

Rig up \_\_\_\_\_

Drilling and Remarks:

Spud 4-21-50  
 10 3/4" @ 210  
 drlg. 2020

**RECORD**

Cased \_\_\_\_\_ in., \_\_\_\_\_ ft.

Sand \_\_\_\_\_

Gas \_\_\_\_\_

Oil \_\_\_\_\_

Total Depth \_\_\_\_\_

**PRODUCTION**

1st 24 hrs. Nat. \_\_\_\_\_

1st 24 hrs. after shot \_\_\_\_\_

Gas \_\_\_\_\_ Cu. Ft.

Dry Hole \_\_\_\_\_

Abandoned \_\_\_\_\_

Date

APR 26 1950 19

J. E. TYRA Scout

Kansas

Map No. \_\_\_\_\_ Sec. 31 Twp. 27 R. 4WWell No. 3 DavisWestgate-Greenland Company

Contractor

NW NE SW

E1.1406:

SECTION PLAT

330 Ft. from N. Line

\_\_\_\_\_ Ft. from S. Line

990 Ft. from E. Line

\_\_\_\_\_ Ft. from W. Line

|                 |   |  |  |
|-----------------|---|--|--|
|                 |   |  |  |
| <b>COMPLETE</b> |   |  |  |
|                 |   |  |  |
|                 | o |  |  |
|                 |   |  |  |

Sedgwick

Location \_\_\_\_\_

Rig up \_\_\_\_\_

Drilling and Remarks:

*10 3/4' c 210**miss 3710-44**5" c 3730**1000 acid**comp. 412 bopd**4% water*

## RECORD

Cased \_\_\_\_\_ in., \_\_\_\_\_ ft.

Sand \_\_\_\_\_

Gas \_\_\_\_\_

Oil \_\_\_\_\_

Total Depth 3744

## PRODUCTION

1st 24 hrs. Nat. \_\_\_\_\_

1st 24 hrs. after shot \_\_\_\_\_

Gas 215 Cu. Ft.

Dry Hole \_\_\_\_\_

Abandoned \_\_\_\_\_

Date

MAY 24 1952 19J. E. TYRA Scout