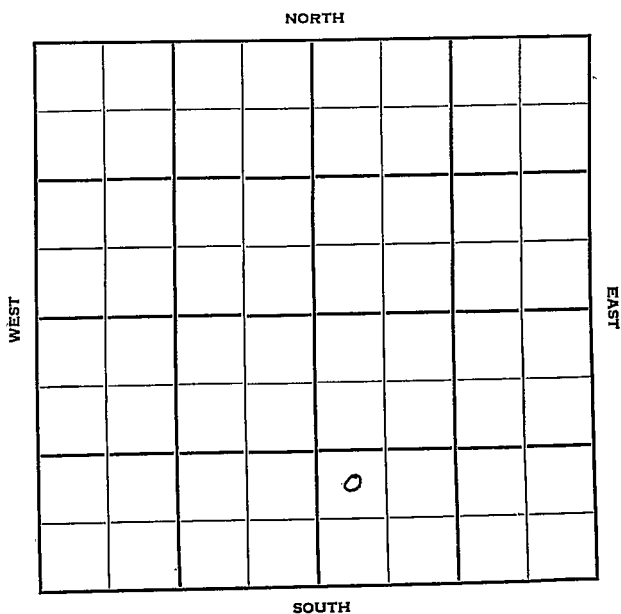


KANSAS

Sedgwick

Section 31 Township 27 Range 4-WWell No. #1 DieffenbocherCompany W. C. McBride

Sedgwick
KANSAS

Sec. 31 Twp. 27 R. 4W

Well No. #1 Dieffenbocher Farm

W. C. McBride Company

Jackson Drlg. Contractor

Bartholomew Pool

Ft. from N. Line

990'


Ft. from S. Line

Ft. from E. Line

330'

Ft. from W. Line

NW SW SE

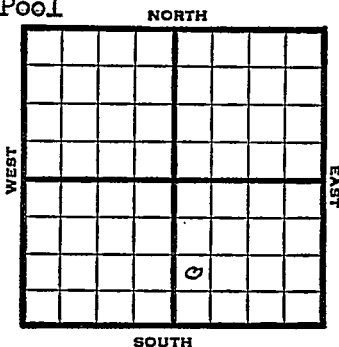

1950

Elev 1415

REPORT

6/14

Spud 5-9-50

10" @ 217'

Drlg. 1137'

8/30

10" @ 217

Br line 2857 Miss chat 3708

Do1 3749

TD 3756

6 5/8" @ 3749

1000 A

S & F/13 boph


Comp 298 bopd

Completed

COMPLETED

Map No. _____ Sec. 31 Twp. 27 R. 4WWell No. 1 Dieffenbocher_____
W. C. McBride Company_____
Jackson Drlg. ContractorNW ⁷ SE

SECTION PLAT

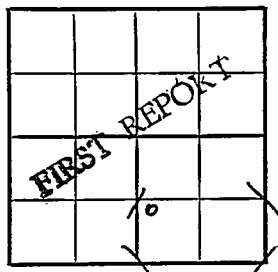_____
Ft. from N. Line990 Ft. from S. Line_____
Ft. from E. Line330 Ft. from W. LineSedgwick County

Location _____

Rig up _____

Drilling and Remarks:

Spud 6-9-50

10" @ 217

drlg. 1137

RECORD

Cased _____ in., _____ ft.

Sand _____

Gas _____

Oil _____

Total Depth _____

PRODUCTION

1st 24 hrs. Nat. _____

1st 24 hrs. after shot _____

Gas _____ Cu. Ft.

Dry Hole _____

Abandoned _____

Date

JUN 14 1950 19 J. F. TYRA Scout

J. E. TYRA