


Section 31 Township 27 Range 11 W

Well No. # 3 Dieffenbacher

Company W. C. McBride

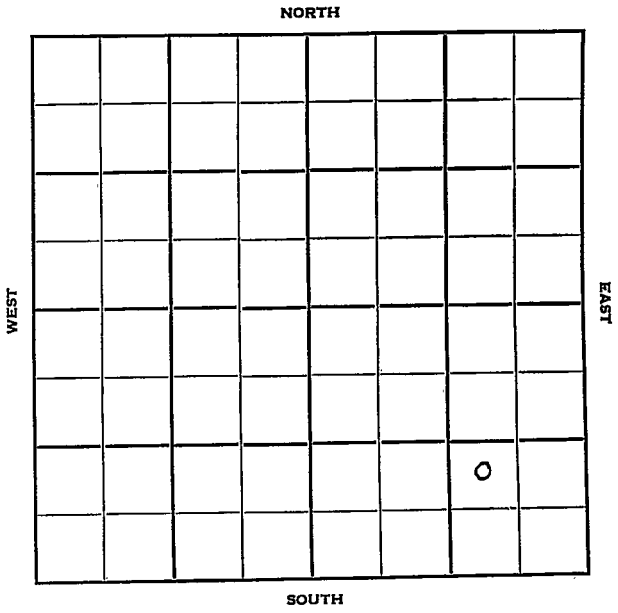

Sec. 31 Twp. 27 R. 4 W

Well No. # 3 Dieffenbacker Farm

W. C. McBride Company

Jackson Drlg. Contractor


Bartholomew Pool
Ft. from N. Line

990 Ft. from S. Line

990 Ft. from E. Line

_____ Ft. from W. Line

NW SE SE

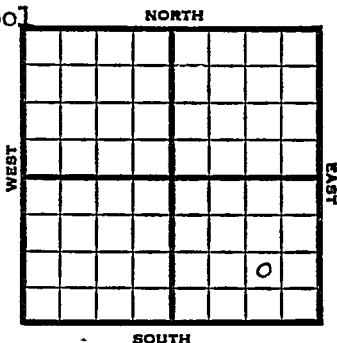

1951

Elev. 1042 REPORT

3/28

Spud 3-21-51

8" @ 218'

Drlg. 2031'

5/9

Spud 3-21-51

Oil Well TD 3776

8" @ 218

Br Lime 2845 Lans. 2888

KC 2973 Miss dol. 3730

Miss ch. 3708 Dol. 3753

TD 3764 5" @ 3749

1000 A DD 3776

39/3741-56 16½ bo 14½ bw

14hr 750 A S/50 bo 25 bw

12 hr.

Comp. 100 bopd 30% wtr.

COMPLETED

Note Spot
Note Feet Measurements
which is correct
Sam

Scout Cards	<i>mm</i>
Land Small Map	
Land Wall Map	
Tracings	
France Map	
Place Map	
Misc.	

APR 3 1951

Orig. Data

MAY 15 1921

Scout Cards	2
Land Small Map	
Land Wall Map	3
Tracings	
France Map	
Pierce Map	
Misc.	