


Sedgwick

Section 31 Township 27 Range 4WWell No. #2 DieffenbacherCompany W.C.McBride

NORTH

WEST

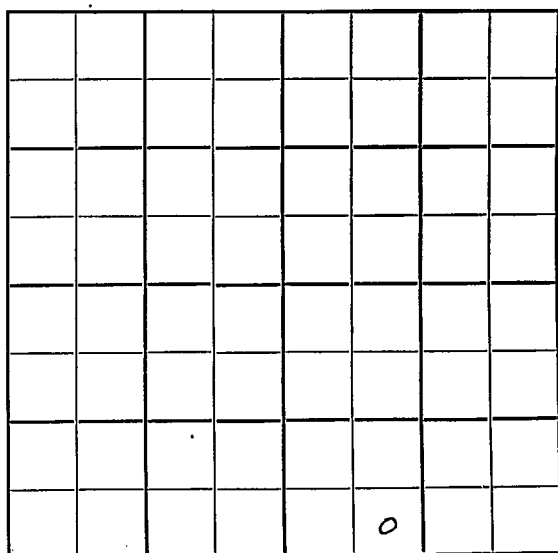

EAST

SOUTH

Sedgwick

KANSAS

Sec. 31 Twp. 27 R. 14 W ✓

Well No. # 2 Dieffenbacker Farm

W. C. McBride Company

Jackson Drlg. Contractor

Bartholomew Pool


Ft. from N. Line

330 Ft. from S. Line

Ft. from E. Line

990 Ft. from W. Line

SE SW SE

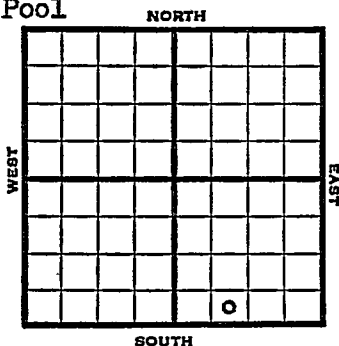

1951

Elev. 1410' REPORT

3/7

Spud 3-5-51
8" @ 209'

5/2

Spud 3-5-51
Oil Well TD 3768
8" @ 209'
Miss ch. 3724 Miss dol. 3764
DST 3758-68 opn $\frac{1}{2}$ hr Rec. 120' ocm
5" @ 3758 TD 3768 1000 A
F/38 bf 1 hr Comp. F/496 bopd

COMPLETED



Operator **W. C. McBride**

Well No. **2** Farm **Dieffenbacher**

Elev.	Location	SE	SW	SE
-------	----------	----	----	----

0

330 Ft. From S Line SE

990 Ft. From W Line Quarter

1st. Report MAR 7 1951

Completion

Remarks

Jackson Drlg. - Contr.

Spudding Date **3-5-51**

Drlg. Data	Bartholomew Pool
------------	------------------

8th @ 209

J. E. TYRA