


Section 31 Township 27 Range 4 W
Well No. #3 Diefenbacher (*Diefenbacher*)
Company L. B. Stableford

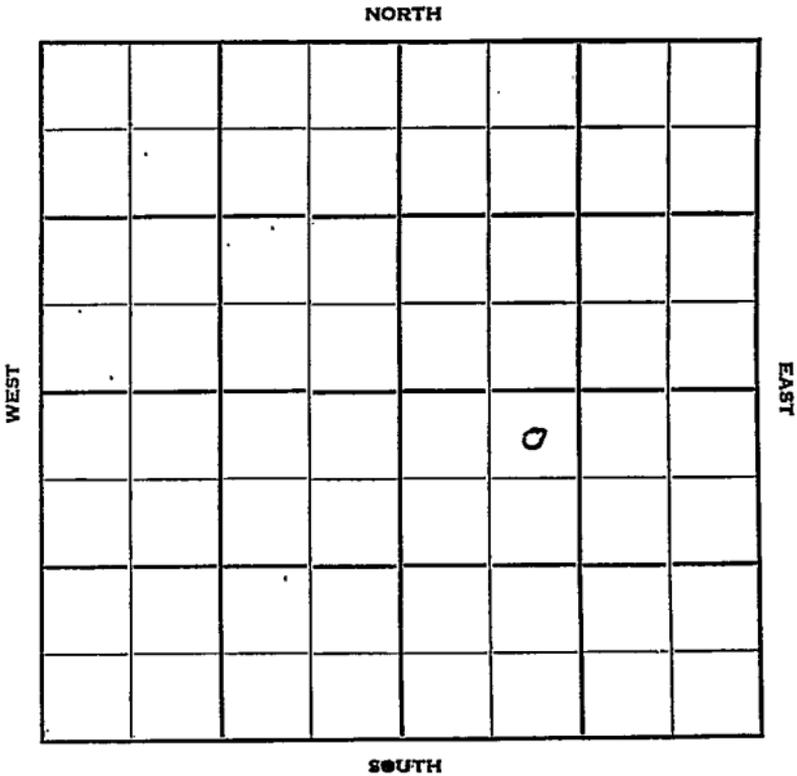

Sedgwick

KANSAS

Sec. 31 " " Twp. " " R. 27 4W

Well No. #3 Diffenbacher Farm

L. B. Stableford Company

K & E Drlg. - Contr. Contractor


Bartholomew Pool

330' Ft. from N. Line

_____ Ft. from S. Line

_____ Ft. from E. Line

990' Ft. from W. Line

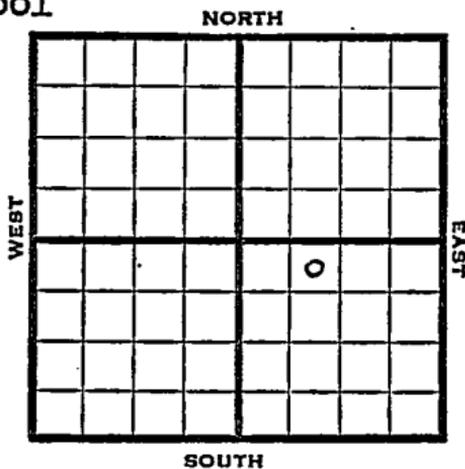

NE NW SE

1951 Elev. 1394' REPORT

1/24 Spud 1-21-51
8" @ 191'

4/11 Spud 1-21-51
Oil Well TD 3732
8" @ 191
Br Line 2842 Lans. 2873
Miss 3682'
TD 3732 5" @ 3712
CO to 3727 500 A F/15 boph
Comp. 215 bopd 4% wtr

COMPLETED

