


Section 31 Township 27 Range 4W

Well No. #4 Dieffenbacher

Company L. B. Stableford

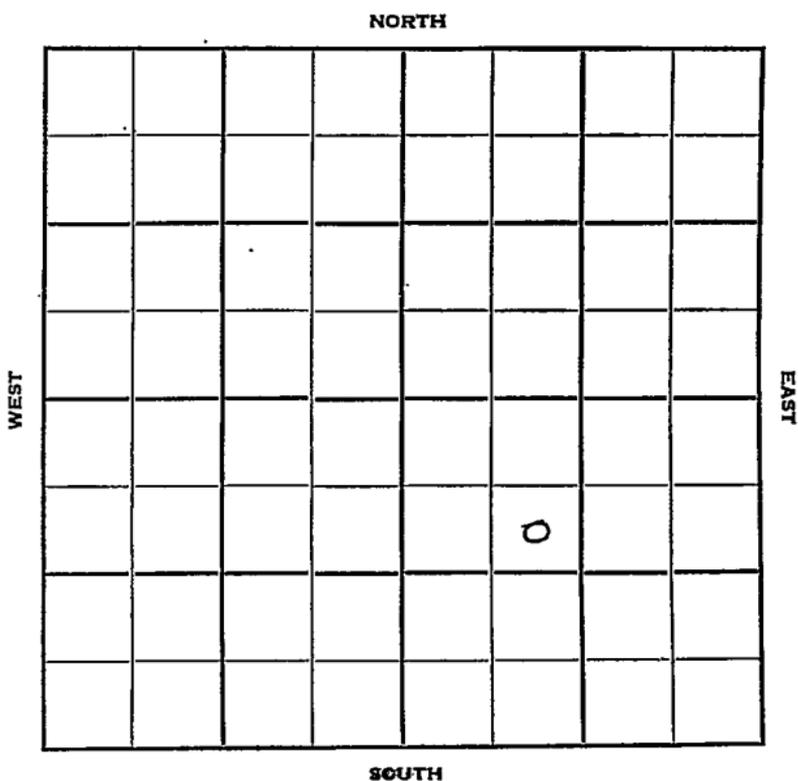

Sec. 31 Twp. 27 R. 4 W ✓

Well No. #4 Dieffenbacher Farm

L. B. Stableford Company

K & E Drlg. Contractor

990 Bartholomew Pool


990 Ft. from N. Line

 Ft. from S. Line

 Ft. from E. Line

990 Ft. from W. Line

SE NW SE

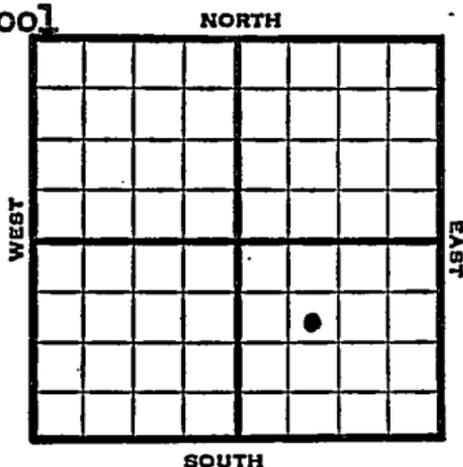

1951

Elev. 1399

REPORT

2/7

Spud 2/5/51
8" @220

3/14

Spud 2-5-51
Oil well TD 3737'
8" @ 220 Br. line 2843', Lans. 287'
Miss 3685, Dol. 3717-37 TD
5" @ 3717 1000 A F/ 40 boph
Comp. 197 bopd
COMPLETED

II

52 • 7 24

FEB 9 1951

Scout Cards	mm	FEB	9 1951
Land Small Map			
Land Wall Map			
Tracings			
France Map			
Pierce Map			
Misc.			

Brig. Date

Scout Cards *7777* MAR 19 1951
Land Small Map.....
Land Wall Map.....
Tracings.....
France Map.....
Pierce Map.....
Misc.

Orig. Date