


Section 6 Township 27 Range 32-W

Well No. #1 George

Company National Assoc. Pet.

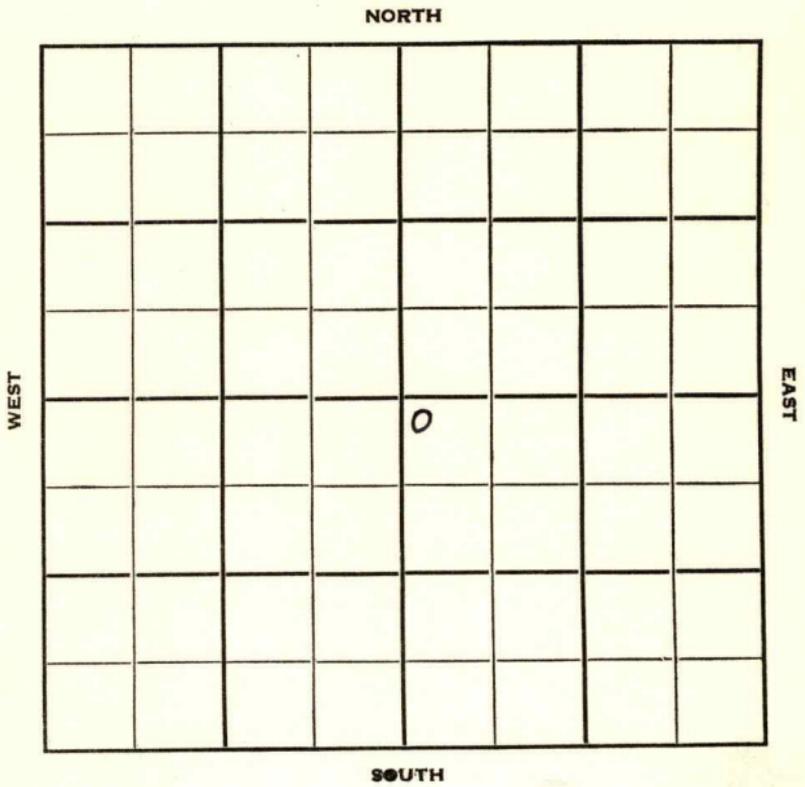

Sec. 6 Twp. 27 R. 32W ✓

Well No. #1 George Farm

National Assoc. Pet. Company

Ferrell Drlg. -Cntr. Contractor

Hugoton Pool


100' Ft. from N. Line

\_\_\_\_\_ Ft. from S. Line

\_\_\_\_\_ Ft. from E. Line

100' Ft. from W. Line

NW SE

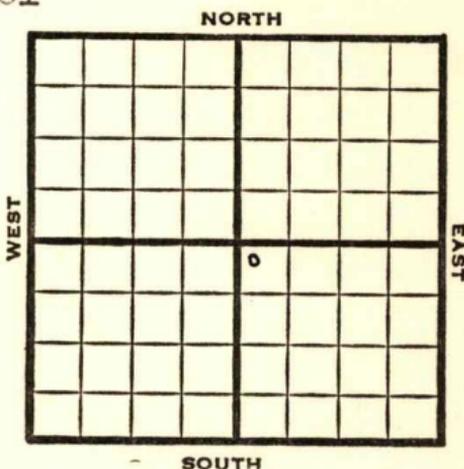

1950

**Elev. 2893**

**REPORT**

11/15

Spud 10-28-50  
Loc.

1951

2/21

Spud 10-28-50  
 Gas Well TD 2706  
 8" @ 620' 5" @ 2676  
**Win. 2676**  
 TD 2706' 176/2610-56 **Her. 2602**  
**Krider 2634'** 20,000 A  
 Comp. 5, 240,000 gas 395#

**COMPLETED**



