


Section 8 Township 27 Range 32 W

Well No. # 1 Towns

Company W. E. Bakke

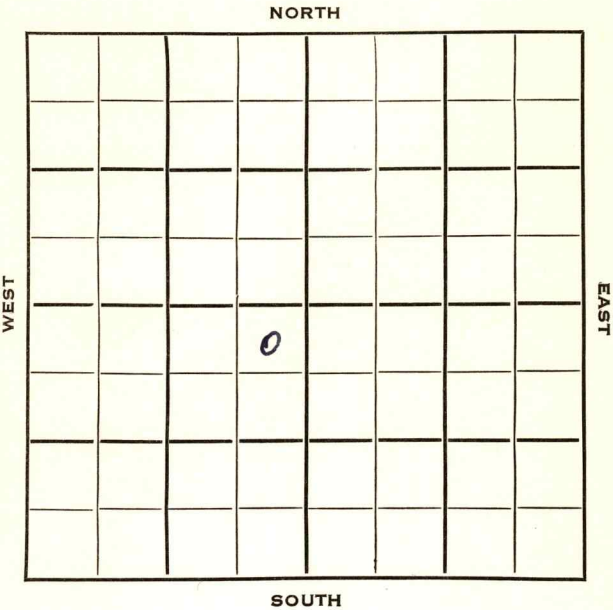

Haskell

KANSAS ✓


Sec. 8 Twp. 27 R. 32WWell No. #1 Towns FarmW. E. Bakke Company

Contractor

Hugoton Pool

330 Ft. from N. Line       Ft. from S. Line330 Ft. from E. Line       Ft. from W. Line

NE NE SW

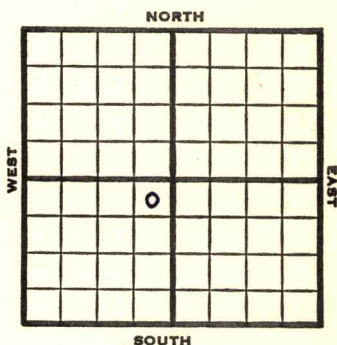

1953

Elev. 2874'

REPORT

5/13

Location

5/21

"

5/28

"

6/3

8" @ 474 5" @ 2609

6/10

RTD 2620 CO 2615 1500 A

DD 2708 TD 2500 A 14,000 A

112' of 4" liner Her 2616 Kr 2646

6/24

Spud 5-24-53

Gas Well

TD 2708

8" @ 474

Her 2616, Kri 2646, Win 2682,

TD 2620

5" @ 2609, CO to 2615, 1500A

DD 2708, 2500A, 14,000A

Comp. 4,605,000 gas

COMPLETED

J. G. McGEHEE

J. G. McGEHEE