


Section 4 Township 27 Range 32W

Well No. 1 Baughman Gas Unit
Stanolind

Company _____

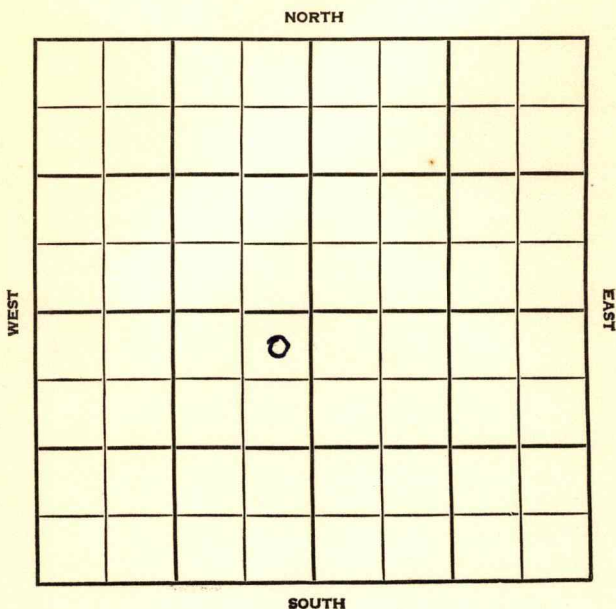

Haskell

KANSAS

SEC.	TWP.	R.
4	27	32 W

WELL NO.	# 1 Baughman Gas Unit	FARM
COMPANY	Stanolind	

CONTRACTOR

Hugoton Pool


150 Ft. from N. Line

Ft. from S. Line

150 Ft. from E. Line

Ft. from W. Line

NE NE SW

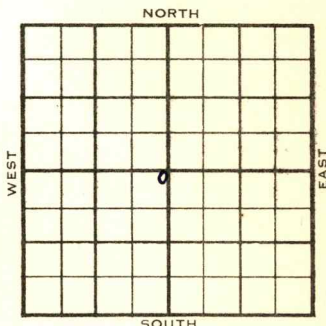

1954	ELEVATION	REPORT
	2880'	

8/4	Spud 7-29-54 8" @ 825' Drlg. 2640'
9/8	Spud 7-29-54 Gas Well TD 2723' 8" @ 825' Her. Her. 2622', Kri 2644', Win 2682' TD 2723' 5 1/2" @ 2696' 8 CO to 2723 2500 A 1,267,000 cfg. SP 2690 96/ 2632-48 24/ 2658-62 36/ 2664-70 12/ 2676-78 3000 A 1,500,000 cfg. 8000 A 1,758,000 cfg. 4000 A 1,581,000 cfg. 20 gwph 2000 A Comp 5,901,000 cfgpd. 325#

COMPLETED

County

State Kansas

Sec.

4

27

32W

Map No.

Operator

Well No.

1

Farm

Baughman Gas Unit

Elev.

Location

NE NE SW

[illegible]

150

Ft. From

N

Line

SW

150

Ft. From

E

Line

Quarter

1st. Report

AUG

4

54

Completion

Remarks

Spudding Date

7-29-54

Drlg. Data

Hugoton Pool

8" @ 825 drlg. 2640

J. G. McGEHEE

County Haskell State KansasSec. 4 (Blk.
Twp.) 27 (Sur.
Rge.) 32W Map No.Operator StanolindWell No. 1 Farm Baughman Gas UnitElev. 2880 Location NE NE SW150 Ft. From N Line SW150 Ft. From E Line Quarter1st. ReportCompletion SEP 8 1954Remarks Hugoton PoolSpudding Date 7-29-54Drlg. Data Gas well TD 27238" @ 825 Her. 2622 Kri. 2644Win. 2682 TD 2723 5 $\frac{1}{2}$ " @ 2696CO to 2723 2500 A 1,267,000 cfgSP 2690 96/ 2632-48 24/ 2658-6236/ 2664-70 12/ 2676-78 3000 A1,500,000 cfg 8000A 1,758,000 cfg4000 A 1,581,000 cfg 20 gwph 2000 AComp. 5,901,000 cfgpd 325#

FABEN GILSTRAP