


Haskell County, Kansas

Section 15 Township 27S Range 32W

Well No. #1 Kelly Gas Unit B

Company Stanolind

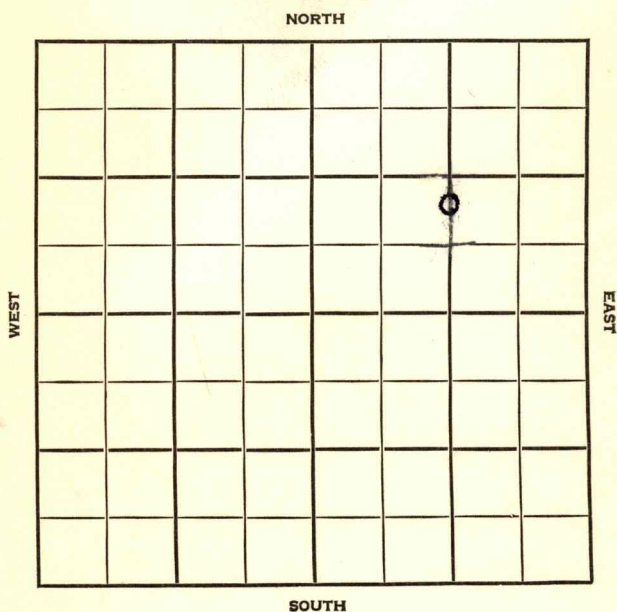

Haskell

KANSAS

SEC.	TWP.	R.
15	27	32W

WELL NO.

#1 Kelly Gas Unit "B"

FARM

COMPANY

Stanolind

CONTRACTOR

Barbour

Hugoton

Ft. from N. Line


1250

Ft. from S. Line

Ft. from E. Line

1320

Ft. from W. Line

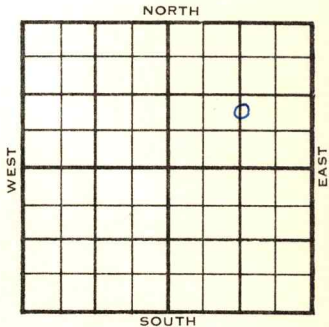C N $\frac{1}{2}$ S $\frac{1}{2}$ NE

1955

ELEVATION

2864 RB

2861 DF

REPORT

9/7

Location

11/2

Comm 9-7-55

8 5/8" @ 832/450

5 1/2" @ 2722/900

Herr 2653

Kri 2677

Winf 2717

TD 2724

CO to 2704 72/2664-82 24/2687-93

12/2696-99 frac 650 mcfg 20 gwph

561 mcfg 25 gwph

Comp 2,344 mcfgpd

COMPLETED

2861 RB
2861 DF

County Haskell Elev. 32W
 Sec. 15 Twp. 27 Rge. 32W
 Company Stanolind
 Farm Name Kelly Gas Unit "B" No. 1

TOPS	DEPTH	LOG	DATUM	Loc. in Sec.
Anh.				C N $\frac{1}{2}$ S $\frac{1}{2}$ NE
Tp.				
H.				1250' SL
Tr.				1320' WL
Dg.				
Bl.				
L.				Geol.
K.C.				Contr.
B.K.C.				Barbour
Ce.				Pool
C.				Hugoton
M.				
M.				
K.				
Mz.				
Mq.				
V.				
S.				
S.				
A.				
R.				
PE.				
G.				
T.D.				

FIRST REPORT
 SEP 7 '54

Date Comm.

Location

35

2864 RB

2861 DF

32W

County Haskell

Elev.

Sec. 15 Twp. 27

Rge.

Company StanolindFarm Name Kelly Gas Unit "B" No. 1

TOPS	DEPTH	LOG	DATUM	Loc. in Sec.
Anh.				
Tp. <u>Herr.</u>	<u>2653</u>			C N $\frac{1}{2}$ S $\frac{1}{2}$ NE
H. <u>Kri</u>	<u>2677</u>			
Tr. <u>Wing</u>	<u>2717</u>			1250' SL
Dg.				1320' WL
Bl.				
L.				
K.C.				Geol.
B.K.C.				
Ce.				Contr.
C.				
M.				Barbour
M.				
K.				Pool
Mz.				Hugoton
Ma.				
V.				
S.				
S.				
A.				
R.				
Pe.				
G.				
T.D.	<u>2724</u>			

COMPLETE

Date Comm. 9-7-55

NOV 2 1955

8 5/8" @ 832/450 5 1/2" @ 2722/900

CO to 2704 72/ 2664-82 24/ 2687-93

12/ 2696-99 frac 650 mcfg 20 gwph

561 mcfg 25 gwph Comp. 2,344 mcfgpd