


KANSAS

Haskell

Section 17 Township 27 Range 32W

Well No. #1 Barber "R"

Company Warren Pet.
Hugoton Pool

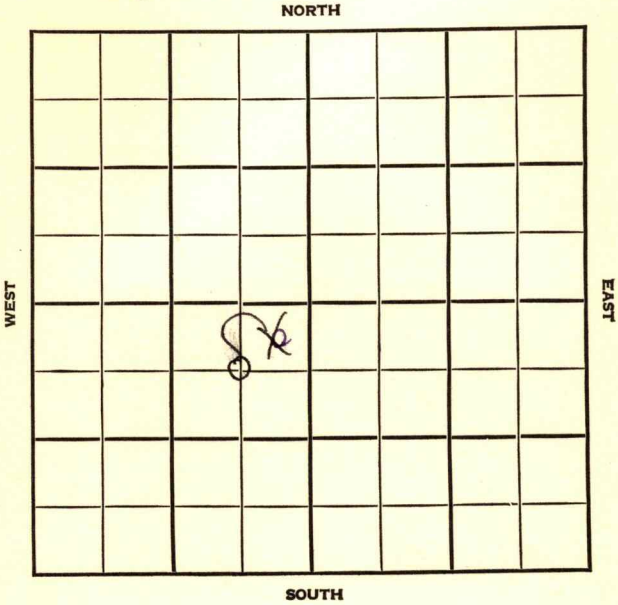

Sec. 17 Twp. 27 R. 32W

Well No. #1 Barber "E" Farm

Warren Pet. Company

Hugoton Pool

NORTH

~~660~~

~~580'~~

Ft. from N. Line

Ft. from S. Line

~~660~~


~~330'~~

Ft. from E. Line

Ft. from W. Line

~~N E SW~~

~~C NE SW~~

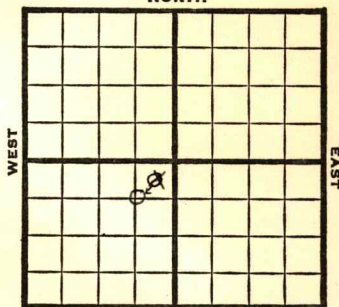

SOUTH

1948

Elev. 2878'

REPORT

5/26

Location

6/1

"

6/9

10" @ 717'

TD 2627'

7" @ 2622'

6/16

"

6/23

"

6/29

"

7/8

7" @ 2622'

115' of 5" Perf liner

26,000 acid

Gas 6,450,000

R. Pr. 410#

TD 2716'

COMPLETED

Kansas

Map No. _____ Sec. 17 Twp. 27 R. 32WWell No. 1 Barber "R"

Warren Pet.

Company _____

FIRST REPORT

Contractor _____

NE SW

SECTION PLAT

		6	

330 Ft. from N. Line

_____ Ft. from S. Line

330 Ft. from E. Line

_____ Ft. from W. Line

Haskell County

Location X

Rig up _____

Drilling and Remarks:

RECORD

Cased _____ in., _____ ft.

Sand _____

Gas _____

Oil _____

Total Depth _____

PRODUCTION

1st 24 hrs. Nat. _____

1st 24 hrs. after shot _____

Gas _____ Cu. Ft.

Dry Hole _____

Abandoned _____

Date

MAY 26 1948 19S. J. LEWIS

Scout

Map No. _____ Sec. 17 Twp. 27 R. 32W

Well No. 1 Barber "E"

Warren Pet.

Company

CORRECTION

Contractor

C NE SW

SECTION PLAT

660 Ft. from N. Line

_____ Ft. from S. Line

660 Ft. from E. Line

_____ Ft. from W. Line

Haskell County

Location _____

Rig up _____

Drilling and Remarks:

Reported

NE SW

RECORD

Cased _____ in., _____ ft.

Sand _____

Gas _____

Oil _____

Total Depth _____

PRODUCTION

1st 24 hrs. Nat. _____

1st 24 hrs. after shot _____

Gas _____ Cu. Ft.

Dry Hole _____

Abandoned _____

Date

JUN 9 1948

19

S. J. LEWIS

Scout

Map No. _____ Sec. 17 Twp. 27 R. 32W

Well No. 1 Barbee "E"

Warren Pet. _____ Company

COMPLETE _____ Contractor

C NE SW

E 12878
SECTION PLAT

660 Ft. from N. Line

_____ Ft. from S. Line

660 Ft. from E. Line

_____ Ft. from W. Line

	o		

Haskell County

Location _____

Rig up _____

Drilling and Remarks:

7" @ 2622
145' by 5" Payline
26000 acid
6,450,000 gal
410# R/B

RECORD

Cased _____ in., _____ ft.

Sand _____

Gas _____

Oil _____

Total Depth 2716

PRODUCTION

1st 24 hrs. Nat. _____

1st 24 hrs. after shot _____

Gas _____ Cu. Ft.

Dry Hole _____

Abandoned _____

Date

JUL 8 1948 19

S. J. LEWIS Scout