

Haskell


FORM 51

KANSAS

Section 24 Township 27 Range 32W

Well No. #1 Miller "T"

Company Cities Service

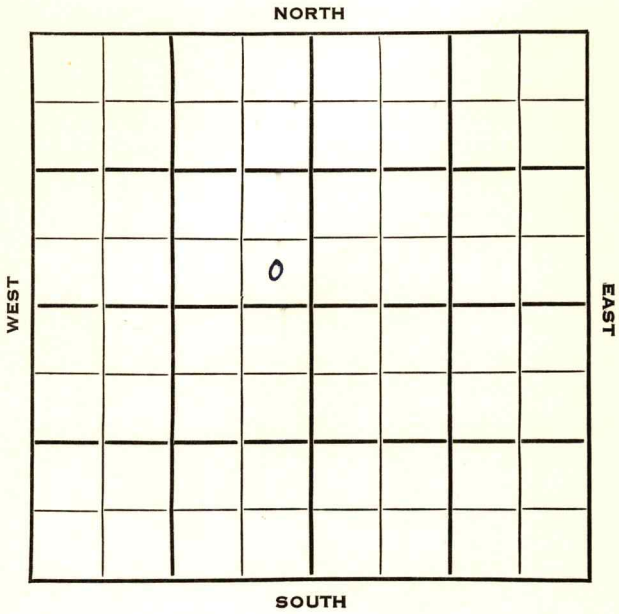

Haskell

ANNEAS

SEC. 24	TWP. 27	R. 32W ✓
---	---	--

WELL NO. #1 Miller "T" FARM

COMPANY Cities Service


CONTRACTOR Holme Drlg.

_____ Ft. from N. Line

100 _____ Ft. from S. Line

100 _____ Ft. from E. Line

_____ Ft. from W. Line

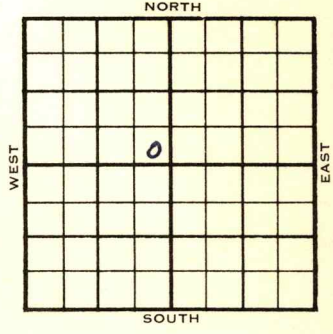

SE SE NW

	ELEVATION	REPORT
1954	2856'	

2/17	Spud 2-24-54 8" @ 760' WOC.
2/24	RTD 2796' Log. 5" @ 2789'
4/28	Spud 2-24-54 Gas well TD 2790 8" @ 760 Anhy 1880 Her. 2644 Kri. 2668 Win. 2728 Ft. Riley 2784' TD 2790 5" @ 2789 CO to 2754 90/2730-48 2000 A 163,000 gas. 200 GSWPH CO to 2718 70/2670-84 2500 A 648,000 gas. 10 qt. wtr. PB 2703 Comp. 1,300,000 gas. 434#

COMPLETED

