


Section 30 Township 27 Range 32W

Well No. #1 Eubank "G"

Company Warren Pet.  
Hugoton Pool

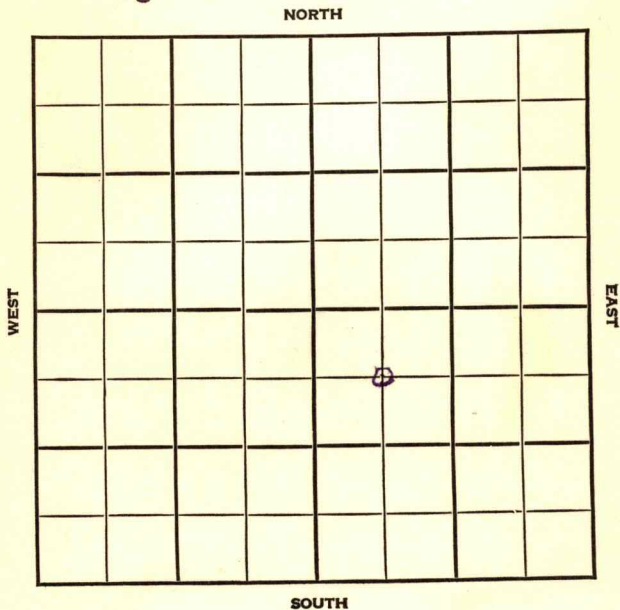

Sec. 30 Twp. 27 R. 32W

Well No. #1 Eubank "G" Farm \_\_\_\_\_

Warren Pet. Company \_\_\_\_\_


Hugoton Pool

660' Ft. from N. Line

\_\_\_\_\_ Ft. from S. Line

\_\_\_\_\_ Ft. from E. Line

660' Ft. from W. Line

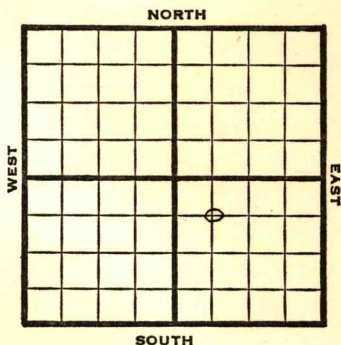

C NW SE

1948

**E1 2930'**

REPORT

5/26

10" @ 653'  
Drlg. 655'

6/11

"

6/9

TD 2761'  
7" @ 2684'

6/16

TD 2761'  
7" @ 2684'  
87' of 5" perf liner @ 2761'  
11000 acid 3,100,000 gas  
420# RaPr.  
Comp

**COMPLETED**

Map No. \_\_\_\_\_ Sec. 30 Twp. 27 R. 32W

Well No. 1 Eubank "G"

Warren Pet. \_\_\_\_\_ Company

FIRST REPORT \_\_\_\_\_ Contractor

C NW SE

SECTION PLAT

660 Ft. from N. Line  
\_\_\_\_ Ft. from S. Line  
\_\_\_\_ Ft. from E. Line  
660 Ft. from W. Line

		o	

Haskell County

Location \_\_\_\_\_

Rig up \_\_\_\_\_

Drilling and Remarks:

10" @ 653

drlg. 655

RECORD

Cased \_\_\_\_\_ in., \_\_\_\_\_ ft.

Sand \_\_\_\_\_

Gas \_\_\_\_\_

Oil \_\_\_\_\_

Total Depth \_\_\_\_\_

PRODUCTION

1st 24 hrs. Nat. \_\_\_\_\_

1st 24 hrs. after shot \_\_\_\_\_

Gas \_\_\_\_\_ Cu. Ft.

Dry Hole \_\_\_\_\_

Abandoned \_\_\_\_\_

Date

MAY 26 1948 19

S. J. LEWIS Scout

Map No. \_\_\_\_\_ Sec. 30 Twp. 27 R. 32W

Well No. 1 Eubank "G"

Warren Pet. \_\_\_\_\_ Company

**COMPLETE** \_\_\_\_\_ Contractor

C NW SE

*E. 1. 2980*  
SECTION PLAT

		o	

660 Ft. from N. Line

\_\_\_\_\_ Ft. from S. Line

\_\_\_\_\_ Ft. from E. Line

660 Ft. from W. Line

Haskell County

Location \_\_\_\_\_

Rig up \_\_\_\_\_

Drilling and Remarks:

*7" @ 2684*

*87' of 5" Perx lines*

*@ 2761*

*11000 @ oil*

*2,100,000 Gas*

*420 RB*

RECORD

Cased \_\_\_\_\_ in., \_\_\_\_\_ ft.

Sand \_\_\_\_\_

Gas \_\_\_\_\_

Oil \_\_\_\_\_

Total Depth 2761

PRODUCTION

1st 24 hrs. Nat. \_\_\_\_\_

1st 24 hrs. after shot \_\_\_\_\_

Gas \_\_\_\_\_ Cu. Ft.

Dry Hole \_\_\_\_\_

Abandoned \_\_\_\_\_

Date

JUN 16 1948

19

S. J. LEWIS

Scout