


Section 31 Township 27 Range 32W

Well No. 1 Yount

Company Warren Pet.

Hugoton Pool

NORTH

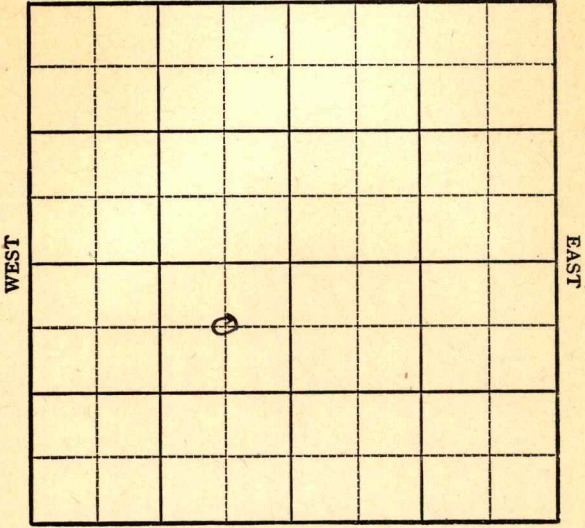

SOUTH

KANSAS

Haskell



Sec. 31 Twp. 27 R. 32W

Well No. #1 Yount Farm

Warren Pet. Company

Hugoton Pool


NORTH

660' Ft. from N. Line

_____ Ft. from S. Line

660' Ft. from E. Line

_____ Ft. from W. Line

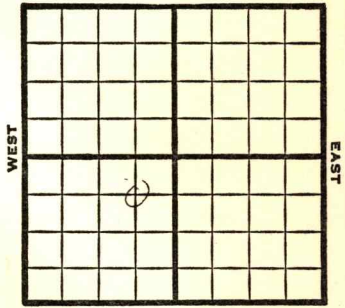

C NE SW

1948

Eli 2935'

REPORT

10/27
11/3

Location
"

11/10

10" @ 590'
Drlgl380

11/16

TD 2681'
7" @ 2672'

11/23

"

11/30

TD 2778'
104' of 5" Perf liner @ 2778'
33,000 acid

12/8

TD 2778'
7" @ 2672'
104' of 5" Perf Liner @ 2778'
33000 acid
8,872,000 Gas
391# R Pr.

Comp

COMPLETED

Map No. _____ Sec. 31 Twp. 27 R. 32W

Well No. 1 Yount

Warren Pet. Company

FIRST REPORT Contractor

C NE SW

SECTION PLAT

660 Ft. from N. Line

_____ Ft. from S. Line

660 Ft. from E. Line

_____ Ft. from W. Line

	o		

Haskell County

Location X

Rig up _____

Drilling and Remarks:

RECORD

Cased _____ in., _____ ft.

Sand _____

Gas _____

Oil _____

Total Depth _____

PRODUCTION

1st 24 hrs. Nat. _____

1st 24 hrs. after shot _____

Gas _____ Cu. Ft.

Dry Hole _____

Abandoned _____

Date

OCT 27 1948

19

S. J. LEWIS Scout

Map No. _____ Sec. 31 Twp. 27 R. 32W

Well No. 1 Yount

Warren Pet. Company

COMPLETE Contractor

C NE SW

E. 2905
SECTION PLAT

660 Ft. from N. Line

_____ Ft. from S. Line

660 Ft. from E. Line

_____ Ft. from W. Line

	0		

Haskell County

RECORD

Location _____

Cased _____ in., _____ ft.

Rig up _____

Sand _____

Drilling and Remarks:

Gas _____

Oil _____

Total Depth 2175'

*7" @ 2672
104' 2 1/5' Prof. Loss*

*@ 2775
33000 acid
5,872,000 Gal*

PRODUCTION

1st 24 hrs. Nat. _____

1st 24 hrs. after shot _____

Gas _____ Cu. Ft.

Dry Hole _____

Abandoned _____

891 R/S

Date

DEC 8 1948 19

S. J. LEWIS Scout