


Section 28 Township 27 **KANSAS** Range 32W

Well No. 1 Giles

Company WarrenPet.

Hugoton Pool
NORTH

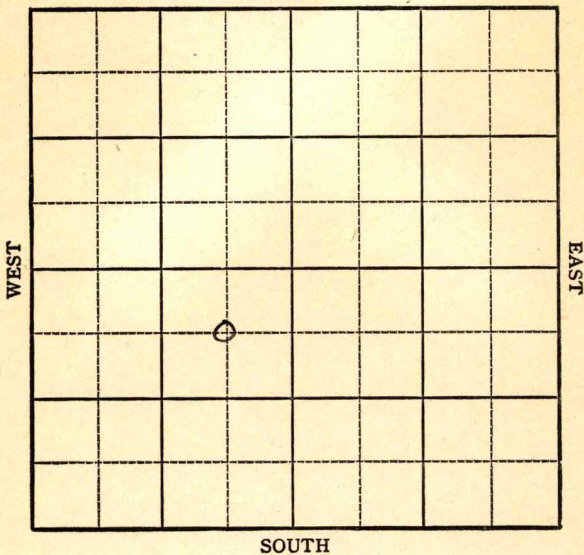

KANSAS

Haskell
27

✓ 32W

Sec. 28 Twp. _____ R. _____

Well No. #1 Giles Farm _____

Warren Pet.

Company _____

Hugoton Pool


660' Ft. from N. Line

_____ Ft. from S. Line

660' Ft. from E. Line

_____ Ft. from W. Line

C NE SW

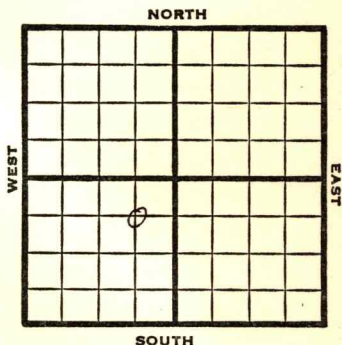

1948

Elev. 2902'

R E P O R T

10/27 Location

11/3 "

11/10 "

11/16 10" @ 579'

Drlg. 900'

11/23 Drlg 2585'

11/30 7" @ 2686' TD

12/6 TD 2765'

3000 acid

107' of 5" Perf liner @ 2765

6000 acid

12/14 "

12/22 7" @ 2686'

107 of 5" Perf liner @ 2765

9000 acid

Gas 2,751,000

RP 410#

TD 2765'

COMPLETED

Map No. _____ Sec. 28 Twp. 27 R. 32W

Well No. 1 Giles

Warren Pet. _____ Company

COMPLETE

Contractor

C NE SW

E 1,2902
SECTION PLAT

660 Ft. from N. Line

_____ Ft. from S. Line

660 Ft. from E. Line

_____ Ft. from W. Line

	0		

Haskell County

RECORD

Location _____

Cased _____ in., _____ ft.

Rig up _____

Sand _____

Drilling and Remarks:

Gas _____

Oil _____

Total Depth 2765

7" @ 2656
167' of 5" Surflines
@ 2765
9000 acid
2,251,000 Gas
410 R.P.

PRODUCTION

1st 24 hrs. Nat. _____

1st 24 hrs. after shot _____

Gas _____ Cu. Ft.

Dry Hole _____

Abandoned _____

Date

DEC 22 1948 19

S. J. LEWIS Scout

Map No. _____ Sec. 28 Twp. 27 R. 32W

Well No. 1 Giles

Warren Pet. Company

FIRST REPORT

Contractor

C NE SW

SECTION PLAT

660 Ft. from N. Line

_____ Ft. from S. Line

660 Ft. from E. Line

_____ Ft. from W. Line

	o		

Haskell County

Location X

Rig up _____

Drilling and Remarks:

RECORD

Cased _____ in., _____ ft.

Sand _____

Gas _____

Oil _____

Total Depth _____

PRODUCTION

1st 24 hrs. Nat. _____

1st 24 hrs. after shot _____

Gas _____ Cu. Ft.

Dry Hole _____

Abandoned _____

Date

OCT 27 1948 19

S. J. LEWIS Scout