


Section 22³² Township 27 Range 35WWell No. #1 E. D. Cooper CCompany Columbian Fuel

NORTH

WEST

EAST

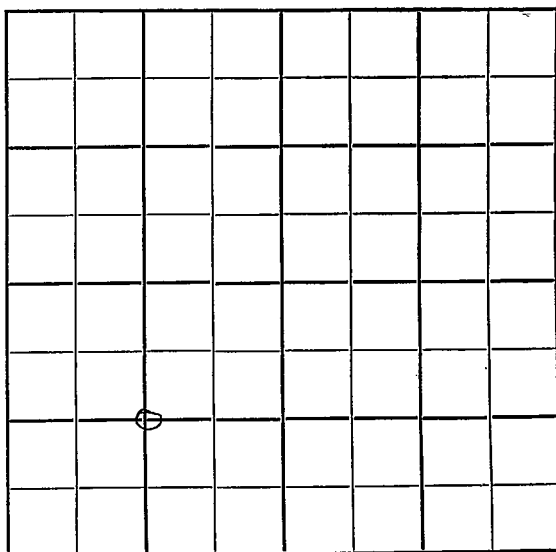

SOUTH

Grant

KANSAS

Sec. 22 Twp: 27 R. 35W

Well No. #1 E. D. Cooper "C" Farm

Columbian Fuel Company

Contractor


 Ft. from N. Line

1320' Ft. from S. Line

 Ft. from E. Line

1320' Ft. from W. Line

G SW/4

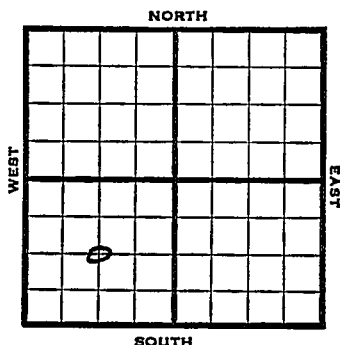


1952 Elev. 3106' REPORT

6/25	Spud 6-22-52
	10" @ 545
7/2	6" @ 2605'
7/9	NR
7/17	RTD 2618'
7/23	1000 A F 2690 DD 2792 TD
7/30	NR
8/6	"
8/13	"
8/20	"
8/27	"
9/3	"
9/10	"
9/17	"
9/24	"
10/1	"
10/8	"
10/15	"
10/22	"
10/29	"
11/5	"
11/12	"
11/20	"

OVER

1952
11/27 NR
12/4 "
12/11 NR
12/18 15,000A
12/25 " "
1/1 NR
1/8 NR
1/22 "
1/29 NR
2/4 Spud 6-22-52
Gas Well
TD 2792
10" @ 545
6" @ 2605
TD 2618, 1000A
DD 2792
Her 2618, Win 2666, Ft. Riley
2703; 15000A
Comp. 1,326,000 gas, 371#

COMPLETED

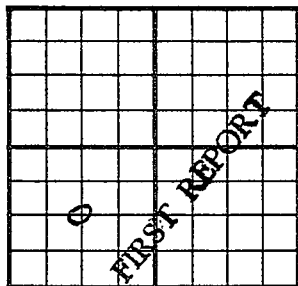County Grant State KansasSec. 22 (Blk. Twp.) 27 (Sur. Rge.) 35W Map No.Operator Columbian FuelWell No. 1 Farm E. D. CooperElev. Location C SW/41320 Ft. From S Line SW1320 Ft. From W Line Quarter1st. Report JUN 25 1952

Completion

Remarks

Spudding Date 6-22-52

Drlg. Data

10" @ 545J. G. McGEHEE

JUN 27

Scout Cards	
Land Small Map	
Land Wall Map	
Tracings	
Frame Map	
Pledge Map	
Misc.	

Drig. Data

Kansas

Map No. _____ Sec. 32 Twp. 27 R. 35W

Well No. 1 E. D. Cooper "C"

Columbian Fuel Company

CORRECTION Contractor

C SW/4


SECTION PLAT

_____ Ft. from N. Line

1320 Ft. from S. Line

_____ Ft. from E. Line

1320 Ft. from W. Line

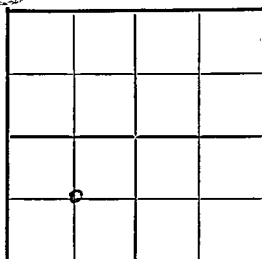

Grant County

Location _____

Rig up _____

Drilling and Remarks:

Reported

22-27-35W

RECORD

Cased _____ in., _____ ft.

Sand _____

Gas _____

Oil _____

Total Depth _____

PRODUCTION

1st 24 hrs. Nat. _____

1st 24 hrs. after shot _____

Gas _____ Cu. Ft.

Dry Hole _____

Abandoned _____

Date

FEB 4 1953


J. G. McGEHEE

Scout

Scout Cards		<i>AS</i>
Land Small Map		
Land Wall Map		<i>AS</i>
Tracings		
France Map		
Pierce Map		
Misc.		

FEB 10 1953

County Grant State Kansas
 Sec. 32 (Blk. 27) (Sur. 35W) (Twp.) Map No.
 Operator Columbian Fuel
 Well No. 1 Farm E. D. Cooper "C"
 Elev. 3106 Location C SW/4

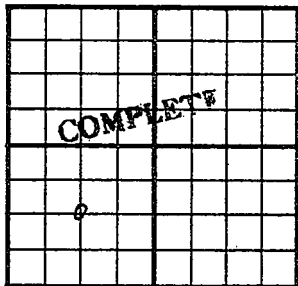

1320 Ft. From S Line SW
1320 Ft. From W Line Quarter
 1st. Report
 Completion FEB 4 1953
 Remarks

Spudding Date 6-22-52
 Drilg. Data Gas well TD 2792
10" @ 545 6" @ 2605 TD 2618 1000 A
DD 2792 Her. 2618 Win. 2666
Ft. Riley 2703 15000 A
Comp. 1,326,000 gas 371#

J. G. McGEHEE

FEB 10 1953

Orig. Date

Scout Cards

Land Small Map

Land Wall Map

Tracings

France Map

Pierce Map

Misc.