


Section 32 Township 27 Range 39W

Well No. 1 Maykew

Company Stanolind

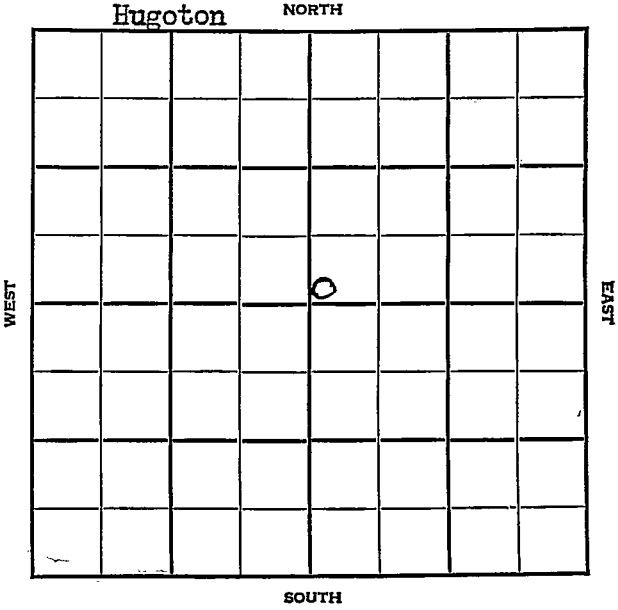



Sec. 32 Twp. 27 R. 39-W

Well No. #1 Maykew Farm

Stanolind Company

Hugoton Pool


         Ft. from N. Line

150' Ft. from S. Line

         Ft. from E. Line

105' Ft. from W. Line

SW NE

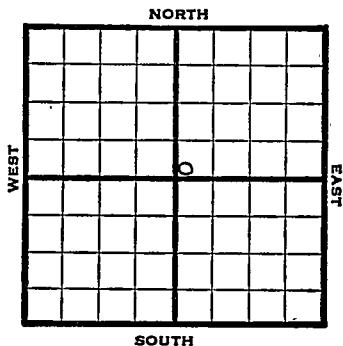

1947

Elev. 3186' REPORT

11/12

Location

11/19

RUR

11/25

8" @ 725'  
Drlg. 1222'

12/3

Drlg. 2477'

12/10

5" @ 2446' Perf.  
15500 acid,  
8,175,000 gas.  
410# R. Pr.  
TD 2488'

**COMPLETED**

Map No. \_\_\_\_\_ Sec. 32 Twp. 27 R. 39W

Well No. 1 Maykew

Stanolind Company

FIRST REPORT Contractor

SW NE

SECTION PLAT

\_\_\_\_\_ Ft. from N. Line

150 Ft. from S. Line

\_\_\_\_\_ Ft. from E. Line

150 Ft. from W. Line

|  |  |   |  |
|--|--|---|--|
|  |  |   |  |
|  |  |   |  |
|  |  | o |  |
|  |  |   |  |
|  |  |   |  |

Stanton County

Location X

Rig up \_\_\_\_\_

Drilling and Remarks:

RECORD

Cased \_\_\_\_\_ in., \_\_\_\_\_ ft.

Sand \_\_\_\_\_

Gas \_\_\_\_\_

Oil \_\_\_\_\_

Total Depth \_\_\_\_\_

PRODUCTION

1st 24 hrs. Nat. \_\_\_\_\_

1st 24 hrs. after shot \_\_\_\_\_

Gas \_\_\_\_\_ Cu. Ft.

Dry Hole \_\_\_\_\_

Abandoned \_\_\_\_\_

Date

NOV 12 1947 19

S. J. LEWIS Scout

Map No. \_\_\_\_\_ Sec. 32 Twp. 27 R. 39W

Well No. I Mayhew

Stanolind Company

**COMPLETE**

Contractor

SWNE

*E. I. S. I. S. C.*

**SECTION PLAT**

\_\_\_\_\_ Ft. from N. Line

150 Ft. from S. Line

\_\_\_\_\_ Ft. from E. Line

150 Ft. from W. Line

|  |  |   |  |
|--|--|---|--|
|  |  |   |  |
|  |  | 0 |  |
|  |  |   |  |
|  |  |   |  |

Stanton County

Location \_\_\_\_\_

Rig up \_\_\_\_\_

Drilling and Remarks:

*5" @ 2446*  
*Perf.*  
*15000 cu ft*  
*5,175,000 gal*  
  
*410 # R/A*

**RECORD**

Cased \_\_\_\_\_ in., \_\_\_\_\_ ft.

Sand \_\_\_\_\_

Gas \_\_\_\_\_

Oil \_\_\_\_\_

Total Depth 2498

**PRODUCTION**

1st 24 hrs. Nat. \_\_\_\_\_

1st 24 hrs. after shot \_\_\_\_\_

Gas \_\_\_\_\_ Cu. Ft.

Dry Hole \_\_\_\_\_

Abandoned \_\_\_\_\_

Date

DEC 1 0 1947 19

S. J. LEWIS

Scout