

KANSAS

Haskell County


FORM 51 IOM 12-46 PETROL

Section 32 Township 27 Range 34-W

Well No. 1 Stanley

Company Cities Service

Hugoton Pool

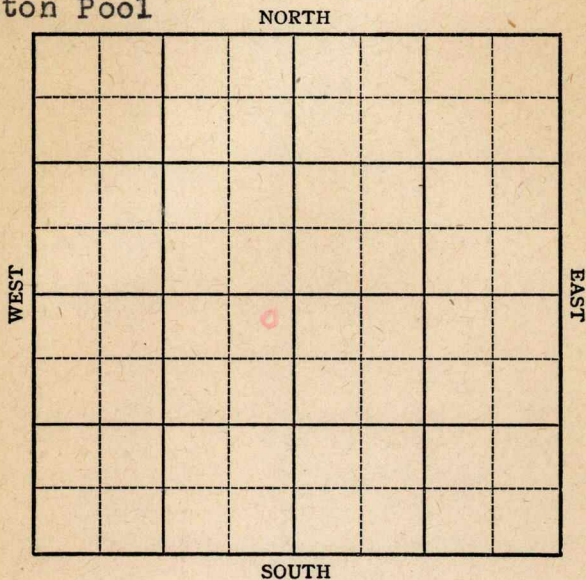

Sec. 32 Twp. 27 R. 34-W

Well No. #1 Stanley Farm

Cities Service Company


Hugoton Pool

100 Ft. from N. Line

Ft. from S. Line

100 Ft. from E. Line

Ft. from W. Line

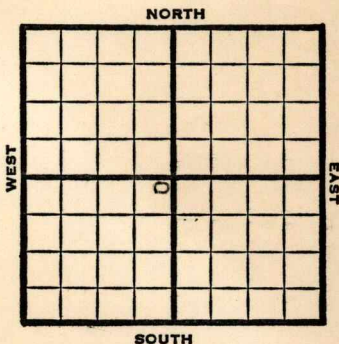

NE SW

1947	Elev. REPORT 3055'
7/9	8" @ 800' WOC
7/16	TD 2815' 5" @ 2814' RUST
7/22	"
7/29	210 shots 2722-64 90 shots 2676-94 104 " 2634-54 40 thots 5614-22 55 shots 2684-95 24750 acid.
8/6	"
8/13	"
8/20	"
8/27	5" @ 2814' Perf. 30,000 acid 20,800,000 Gas 388# RPr Total Depth 2815'
	COMPLETED

Map No. _____ Sec. 32 Twp. 27 R. 34W

Well No. 1 Stanley

Cities Service

Company

FIRST REPORT

Contractor

NE SW

SECTION PLAT

	6		

100 Ft. from N. Line

_____ Ft. from S. Line

100 Ft. from E. Line

_____ Ft. from W. Line

Haskell County

Location _____

Rig up _____

Drilling and Remarks:

8" @ 800 WOC

RECORD

Cased _____ in., _____ ft.

Sand _____

Gas _____

Oil _____

Total Depth _____

PRODUCTION

1st 24 hrs. Nat. _____

1st 24 hrs. after shot _____

Gas _____ Cu. Ft.

Dry Hole _____

Abandoned _____

Date

JUL 9 1947

19

S. J. LEWIS

Scout

Map No. 0 Sec. 32 Twp. 27 R. 34W

Well No. 1 Stanley

Cities Service

Company

COMPLETE

Contractor

NE SW


E 1.3053
SECTION PLAT

100 Ft. from N. Line

 Ft. from S. Line

100 Ft. from E. Line

 Ft. from W. Line

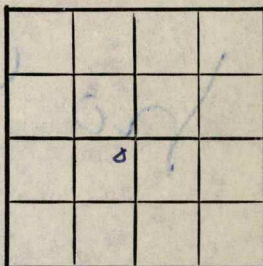

Haskell County

Location

Rig up

Drilling and Remarks:

5' @ 2814

Perf.

8000000000

20,800,000 Gas

088 R/R

RECORD

Cased in., ft.

Sand

Gas

Oil

Total Depth 2815

PRODUCTION

1st 24 hrs. Nat.

1st 24 hrs. after shot

Gas Cu. Ft.

Dry Hole

Abandoned

Date

AUG 27 1947 19 S. J. LEWIS Scout