


Section 32 Township 27 Range 5W

Well No. #1 Cavit

Company Pabco Drlg.

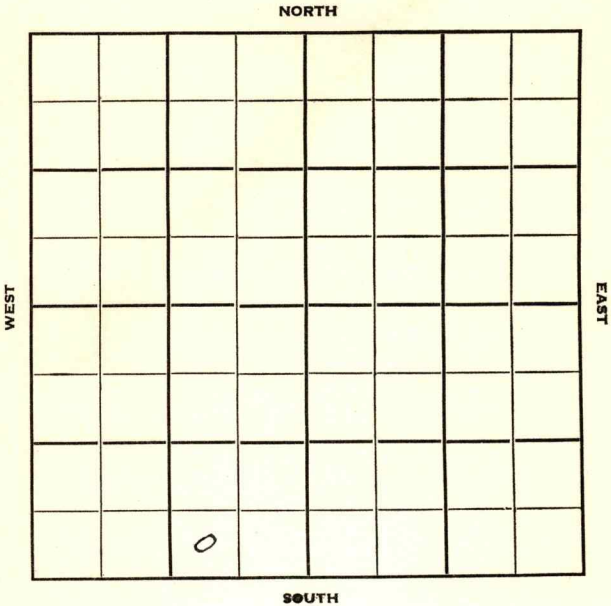

Kingman

KANSAS

Sec. 32 Twp. 27 R. 5W

Well No. #1 Cavit Farm ✓

Pabco Drlg.

Company

Pabco - Contr.

Contractor

Wildcat

Ft. from N. Line

330'


Ft. from S. Line

990'

Ft. from E. Line

Ft. from W. Line

SW SE SW

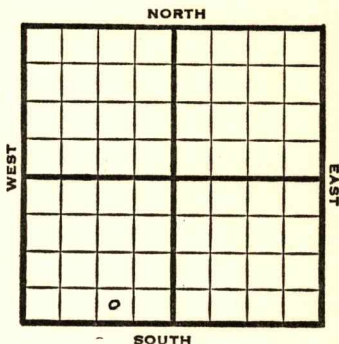

1950

Elev. 1434'

REPORT

11/22

Spud 11-15-50

8-5/8" @ 161'

Drlg. 2890'

12/6

8 5/8" @ 161

KC 2974

DST 3380-96 opn 1 hr rec 60' mud

400' o & gcm 170' sw

Miss 3784

DST 3785-3805 opn 1 hr rec 350' ocm
& water

DST 3818-30 opn 1 hr rec 120' sw

TD 3830

D&A

ABANDONED

County Kingman State KansasSec. 32 (Blk. Twp.) 27 (Sur. Rge.) 5W Map No.Operator Pabco Drlg.Well No. 1 Farm CavitElev. 1434 Location SW SE SW

FIRST REPORT


330 Ft. From S Line SW990 Ft. From E Line Quarter1st. Report NOV 22 1950

Completion

Remarks

Pabco - Contr.Spudding Date 11-15-50Drlg. Data Wilcoat8 5/8" @ 161 drlg. 2890

J. E. TYRA

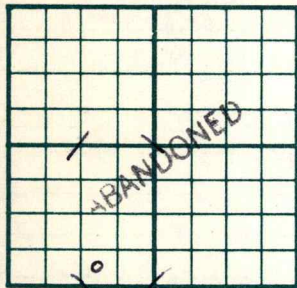County Kingman State KansasSec. 32 (Blk. 27 (Sur. 5W (Twp. 5W Map No. 5WOperator Pabco Drlg.Well No. 1 Farm CavitElev. 1434 Location SW SE SW330 Ft. From S Line SW990 Ft. From E Line Quarter1st. Report Completion DEC 6 1950Remarks WildcatPabco - Contr.Spudding Date 11-15-50Drlg. Data D & A TD 38308 5/8" @ 161 KC 2974 DST 3380-96open 1 hr. Rec. 60' mud 400' o & gcm170' sw Miss. 3784 DST 3785-3805open 1 hr. Rec. 350' ocm & waterDST 3818-30 open 1 hr. Rec. 120' swTD 3830 D & A

J. E. TYRA