


Section 1 Township 27 Range 33-W

Well No. #1 Tate

Company National Assoc. Pet.

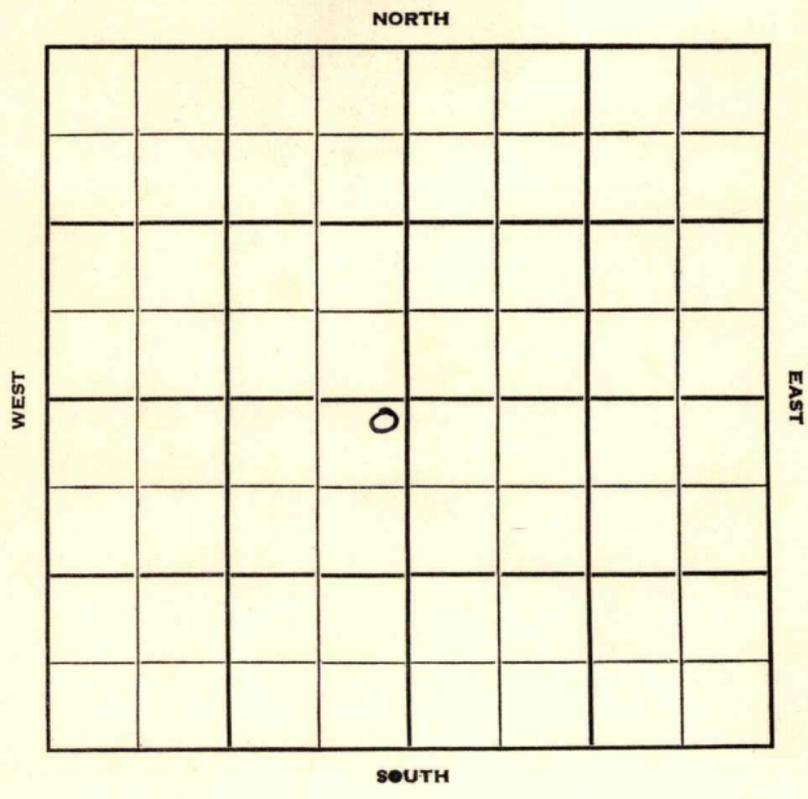



Sec. 1 Twp. 27 R. 33W

Well No. #1 Tate Farm

National Assoc. Pet. Company

Transit Drlg. - Contr. Contractor

Hugoton Pool


100' Ft. from N. Line

\_\_\_\_\_ Ft. from S. Line

100' Ft. from E. Line

\_\_\_\_\_ Ft. from W. Line

NE SW

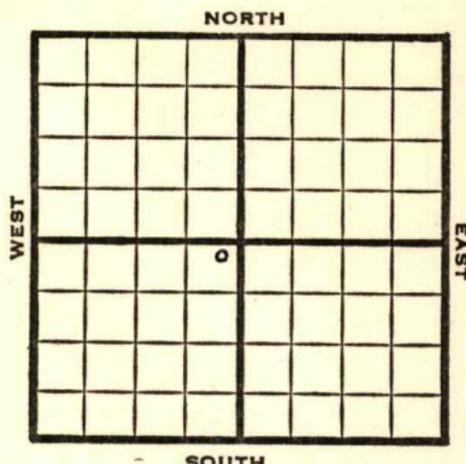

1950

**Elev. 2915'** REPORT

11/15

Spud 10-20-50  
Loc.

1951

2/21

Spud 10-20-50  
Gas Well TD 2700  
8" @ 608' 5" @ 2673  
TD 2700' **Her. 2608**  
**Krider 2630 Win 2669**  
264/2610-54 20000 A  
Comp. 7 ,434,000 gas 380#

**COMPLETED**



