

KANSAS

Haskell

Section 3 Township 27 Range 33W

Well No. 1 Atkins "H"

Company Cities Service

Hugoton

NORTH

WEST

EAST

			0				

SOUTH

Haskell

KANSAS ✓

Sec. 3 Twp. 27 R. 33W

Well No. #1 Atkins "H" Farm

Cities Service

Company

Hugoton Pool (Corbett & Barbar ^{NORTH} Cont.)


100' Ft. from N. Line

 Ft. from S. Line

100' Ft. from E. Line

 Ft. from W. Line

NE SW

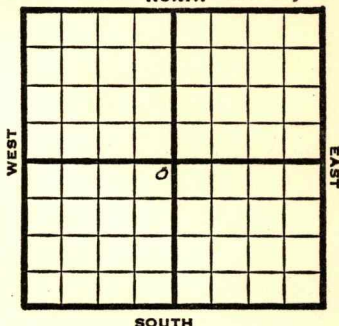

1949

Elev 2926' REPORT

10/19

Location

10/26

8" @ 759'

Drlg. 2600'

11/1

TD 2790

5"@ 2789'

120 shots 2730-2766

5500 acid

11/9

250 shos 2620-2698'

3500 acid

11/16

19000 acid

11/23

"

11/30

TD 2790'

5"@ 2789'

Perf

39000 acid

12,800,000 Gas

409# R Pr.

Comp

COMPLETED

Map No. _____ Sec. 3 Twp. 27 R. 33W

Well No. 1 Atkins "H"

Cities Service

Company

Corbett & Barber

Contractor

NE SW

FIRST REPORT
SECTION PLAT

100 Ft. from N. Line

_____ Ft. from S. Line

100 Ft. from E. Line

_____ Ft. from W. Line

	D		

Haskell County

Location X

Rig up _____

Drilling and Remarks:

RECORD

Cased _____ in., _____ ft.

Sand _____

Gas _____

Oil _____

Total Depth _____

PRODUCTION

1st 24 hrs. Nat. _____

1st 24 hrs. after shot _____

Gas _____ Cu. Ft.

Dry Hole _____

Abandoned _____

Date

OCT 19 1949

19

S. J. LEWIS

Scout

Map No. _____ Sec. 3 Twp. 27 R. 33W

Well No. 1 Atkins "H"

Cities Service

Company

COMPLETE

Contractor

NE SW

E1.2926
SECTION PLAT

100 Ft. from N. Line

_____ Ft. from S. Line

100 Ft. from E. Line

_____ Ft. from W. Line

Haskell County

	6		

Location _____

Rig up _____

Drilling and Remarks:

5' 22789

Perf.

37000 acid

12,800,000 Gall

409 # R/A

RECORD

Cased _____ in., _____ ft.

Sand _____

Gas _____

Oil _____

Total Depth *2780*

PRODUCTION

1st 24 hrs. Nat. _____

1st 24 hrs. after shot _____

Gas _____ Cu. Ft.

Dry Hole _____

Abandoned _____

Date

NOV 30 1949

19

S. J. LEWIS

Scout