


Section 8 Township 27 Range 33W
Well No. #1 Atkins "G"
Company Cities Service

NORTH

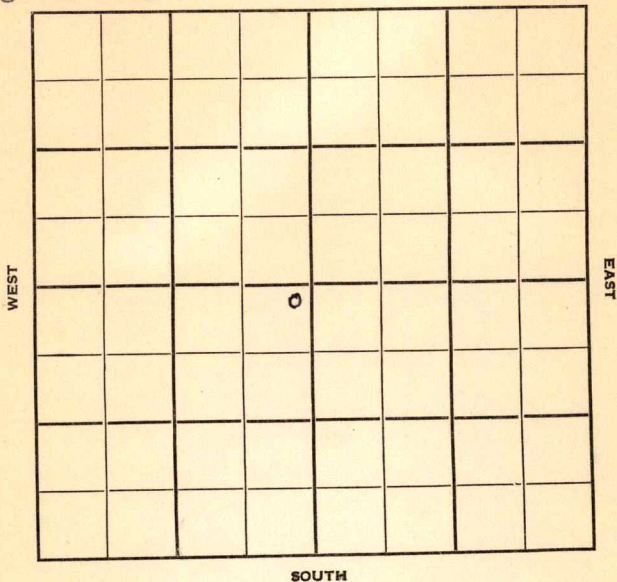

Haskell

KANSAS

Sec. 8 Twp. 27 R. 33W ✓

Well No. #1 Atikins "G" Farm _____

Cities Service Company
Hugoton Pool (Corbett & Barber Contr.)


200' Ft. from N. Line

_____ Ft. from S. Line

200' Ft. from E. Line

_____ Ft. from W. Line

NE SW

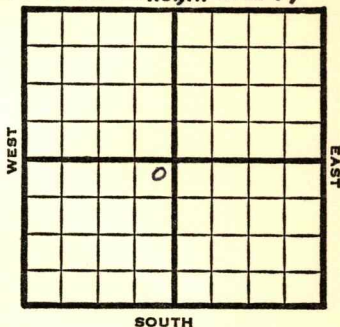

1949

REPORT

12/7 RUR

12/14 8" @ 800'
Drlg. 2250'

1950
2/1 TD 2780'
8" @ 800'
5" @ 2779'
Heb 2584'
Kr 2609'
Win 2667'

Perf 110/2728-34

Perf 40/2710-26'

Perf 140/2660-68'

Perf 120/2608-32'

Used 25,000

Flow 14,800,000 cu ft gas per day

Comp

COMPLETED

Kansas

Map No. _____ Sec. 8 Twp. 27 R. 33WWell No. 1 Atikins "G"

Cities Service

Company

Corbett & Barber

Contractor


NE SW

FIRST REPORT
SECTION PLAT200 Ft. from N. Line

_____ Ft. from S. Line

200 Ft. from E. Line

_____ Ft. from W. Line

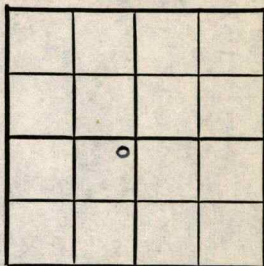

Haskell County

Location _____

Rig up _____

Drilling and Remarks:

R U R

RECORD

Cased _____ in., _____ ft.

Sand _____

Gas _____

Oil _____

Total Depth _____

PRODUCTION

1st 24 hrs. Nat. _____

1st 24 hrs. after shot _____

Gas _____ Cu. Ft.

Dry Hole _____

Abandoned _____

Date

DEC 7 1949 19S. J. LEWIS Scout

Kansas

Map No. _____ Sec. 8 Twp. 27 R. 33WWell No. 1 Atkins "G"

_____ Cities Service _____ Company

_____ Contractor

NE SW

SECTION PLAT

200 Ft. from N. Line

_____ Ft. from S. Line

200 Ft. from E. Line

_____ Ft. from W. Line

COMPLETE			
	o		

Haskell County

Location _____

Rig up _____

Drilling and Remarks:

8' @ 8005" @ 2779Rev. 2584Rev. 2609Win 2667(over)

RECORD

Cased _____ in., _____ ft.

Sand _____

Gas _____

Oil _____

Total Depth 2780

PRODUCTION

1st 24 hrs. Nat. _____

1st 24 hrs. after shot _____

Gas _____ Cu. Ft.

Dry Hole _____

Abandoned _____

Date

FEB 1 1950 19

J. E. TYRA

Scout

perf 110/2728-34

40/2710-26

140/2660-68

120/2608-32

used 25,000

flow 14,800,000

cu ft gas per day

Scout Cards

Land Small Map

Land Wall Map

Tracings

France Map

Pierce Map

Misc.

FEB 7 1950