


Section 22 Township 27 Range 33W

Well No. #1 L. Marcotte

Company National Assoc. Pet.

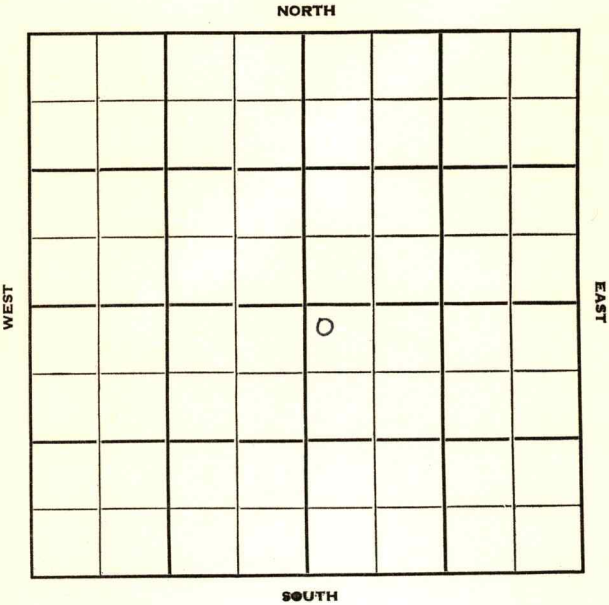

Haskell

KANSAS

Sec. 22 Twp. 27 R. 33W ✓

Well No. #1 L. Marcotte Farm

National Assoc. Pet. Company

Ferrell Drlg. - Contr. Contractor

Hugoton Pool


100' Ft. from N. Line

_____ Ft. from S. Line

_____ Ft. from E. Line

100' Ft. from W. Line

NW SE

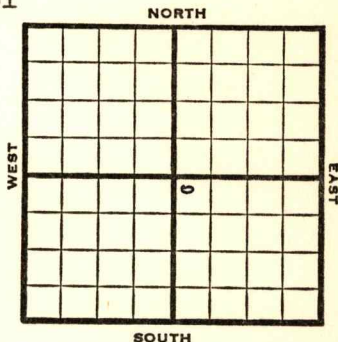

1950

Elev. 2931' REPORT

11/29

Spud 11-25-50
8" @ 604'
Drlg. 2510'

1951
2/21

Spud 11-25-50
Gas well TD 2704
8" @ 604 5" @ 2702
TD 2704' **Her. 2636**
Krider 2654 Win 2703
240/2638-78 26,000 A
Comp. 6,750,000 gas 390#

COMPLETED

County Haskell State KansasSec. 22 (Blk.
Twp.) 27 (Sur.
Rge.) 33W Map No.Operator National Assoc. Pet.Well No. 1 Farm L. MarcotteElev. 2931 Location NW SE

100 Ft. From N Line SE100 Ft. From W Line Quarter1st. Report NOV 29 1950

Completion

Remarks

Ferrell Drlg. - Cont.Spudding Date 11-25-50Drlg. Data Hugoton Pool8" @ 604 drlg. 2510

J. E. TYRA

County Haskell State KansasSec. 22 (Blk. Twp.) 27 (Sur. Rge.) 33W Map No.Operator National Assoc. Pet.Well No. 1 Farm MarcotteElev. 2931 Location NW SE100 Ft. From N Line SE100 Ft. From W Line Quarter

1st. Report

Completion FEB 21 1951Remarks Hugoton PoolFerrell Drlg. - Contr.Spudding Date 11-25-50Drlg. Data Gas well TD 27048" @ 604 5" @ 2702 TD 2704 Her. 2636Krider 2654 Win. 2703 240/ 2638-7826000 A Comp. 6,750,000 gas 390#

J. E. TYRA