


Section 4 Township 27 Range 33W

Well No. #1 Aitikins "F"


Company Cities Service

Hugoton Pool

NORTH

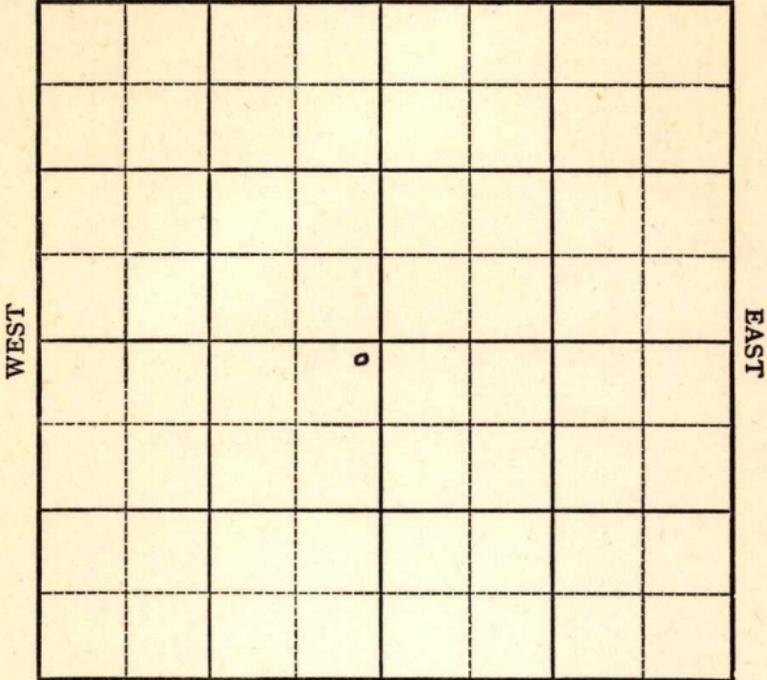

SOUTH

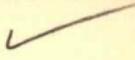

Sec. 4 Twp. 27 R. 33-W

Well No. #1 Atikins "F" Farm _____

Cities Service

Company


Hugoton Pool (Corbett & Barber Contr.)

100 Ft. from N. Line

_____ Ft. from S. Line

100 Ft. from E. Line

_____ Ft. from W. Line

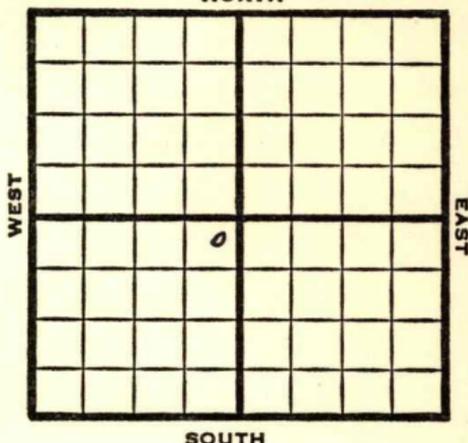

NE SW

REPORT

1949

12/14

8"@ 760'
Drlg 2560'

12/21

TD 2970'
5"@ 2789'

12/28

"

1950

1/18

TD 2970'
8"@ 760'
5"@ 2789'
Her 2585'
Kr 2614'
Win 2672'
Tor 2726'

Perf 24/2748-62

Perf 30/2728-34

Perf 60/2684-92

Perf 30/2672-78

Perf 80/2640-56

Perf 80/2016-32

Flowed 15,900,000 cu ft gas per day
Comp

COMPLETED

Map No. _____ Sec. 4 Twp. 27 R. 33W

Well No. 1 Aitikins "F"

Cities Service Company

Corbett & Barber Contractor

NE SW

FIRST REPORT
SECTION PLAT

100 Ft. from N. Line

_____ Ft. from S. Line

100 Ft. from E. Line

_____ Ft. from W. Line

	o		

Haskell County

Location _____

Rig up _____

Drilling and Remarks:

8" @ 760

drlg. 2560

RECORD

Cased _____ in., _____ ft.

Sand _____

Gas _____

Oil _____

Total Depth _____

PRODUCTION

1st 24 hrs. Nat. _____

1st 24 hrs. after shot _____

Gas _____ Cu. Ft.

Dry Hole _____

Abandoned _____

Date

DEC 14 1949 19

S. J. LEWIS Scout

Kansas

Map No. _____ Sec. 4 Twp. 27 R. 33W

Well No. 1 Atikins "F"

_____ Cities Service _____ Company

_____ Contractor

NE SW

SECTION PLAT

100 Ft. from N. Line

_____ Ft. from S. Line

100 Ft. from E. Line

_____ Ft. from W. Line

COMPLETE			
	o		

Haskell County

Location _____

Rig up _____

Drilling and Remarks:

8' @ 760
5' @ 2789
 Net. 2585,
 Kr 2614
 Win 2672
 Lov 2726

RECORD

Cased _____ in., _____ ft.

Sand _____

Gas

Oil _____

Total Depth 2970

PRODUCTION

1st 24 hrs. Nat. _____

1st 24 hrs. after shot _____

Gas _____ Cu. Ft.

Dry Hole _____

Abandoned _____

Date _____

(over)

JAN 18 1950

J. E. TYRA

19

Scout

perf - 24/2748-62

" 30/2728-34

" 60/2684-92

" 30/2672-78

" 80/2640-56

" 80/2016-32

Flamed 15,900,000
cu ft gas per day.

JAN 20 1950

Scout Cards	<i>Scout</i>
Land Small Map	
Land Wall Map	<i>3</i>
Tracings	
France Map	
Pierce Map	
Misc.	