

Haskell

FORM 51 25M 3-49 PETROL


KANSAS

Section 9 Township 27S Range 33W

Well No. #1 Atkins

Company Cities Service

NORTH

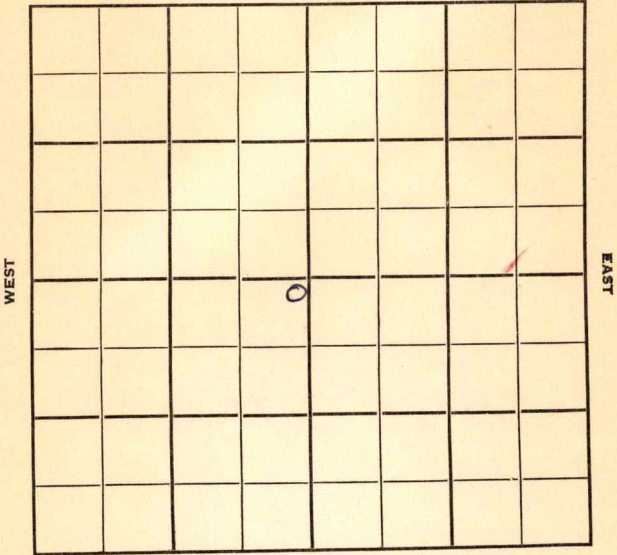

SOUTH

KANSAS

Haskell

Sec. 9 Twp. 27 R. 33-W

Well No. #1 Atikins Farm

Cities Service

Company


Cont- Corbett & Barber

100 Hugoton Pool
Ft. from N. Line

Ft. from S. Line

100 Ft. from E. Line

Ft. from W. Line

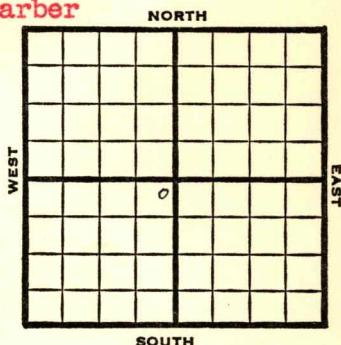

NE SW

1949	Elev 2943'	REPORT
10/5	8"@ 760'	
10/12	TD 2785'	
	5 @ 2784'	
10/19	356 shots 2622-2766	
	4500 acid	
10/26	Acid 29,000	
11/1	"	
11/9	"	
11/16	"	
11/23	"	
11/29	"	
12/7	"	
12/14	"	
12/28	TD 2785'	
	5"@ 2784'	
	Perf	
	33500 acid	
	6,540,000 Gas	
	429# R Pr.	
	Comp	

COMPLETED

Map No. _____ Sec. 9 Twp. 27 R. 33W

Well No. 1 Atikins

Cities Service

Company

Corbett & Barber

Contractor

NE SW


FIRST REPORT
SECTION PLAT

100 Ft. from N. Line

_____ Ft. from S. Line

100 Ft. from E. Line

_____ Ft. from W. Line

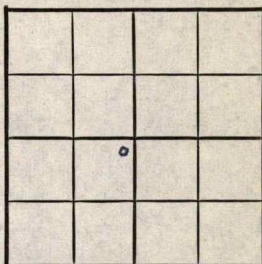

Haskell County

Location _____

Rig up _____

Drilling and Remarks:

8" @ 760

RECORD

Cased _____ in., _____ ft.

Sand _____

Gas _____

Oil _____

Total Depth _____

PRODUCTION

1st 24 hrs. Nat. _____

1st 24 hrs. after shot _____

Gas _____ Cu. Ft.

Dry Hole _____

Abandoned _____

Date

OCT 5 1949

S. J. LEWIS

Scout

Kansas

Hugoton Pool

Map No. _____ Sec. 9 Twp. 27 R. 33WWell No. 1 Atikins


Cities Service

Company

COMPLETE

Contractor

NE SW

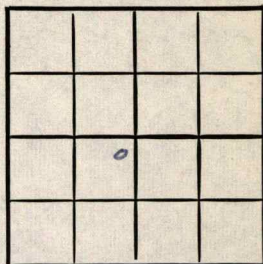21,2943
SECTION PLAT100 Ft. from N. Line

_____ Ft. from S. Line

100 Ft. from E. Line

_____ Ft. from W. Line

Haskell County

Location _____

Rig up _____

Drilling and Remarks:

5" @ 2784

Perf

8850 sand

6,540,500 gal

4292 R/B

RECORD

Cased _____ in., _____ ft.

Sand _____

Gas _____

Oil _____

Total Depth 2785

PRODUCTION

1st 24 hrs. Nat. _____

1st 24 hrs. after shot _____

Gas _____ Cu. Ft.

Dry Hole _____

Abandoned _____

Date

DEC 28 1949

19

S. J. LEWIS

Scout