


Section 11 Township 27 Range 33-W

Well No. #1 Atkins

Company National Assoc. Pet.

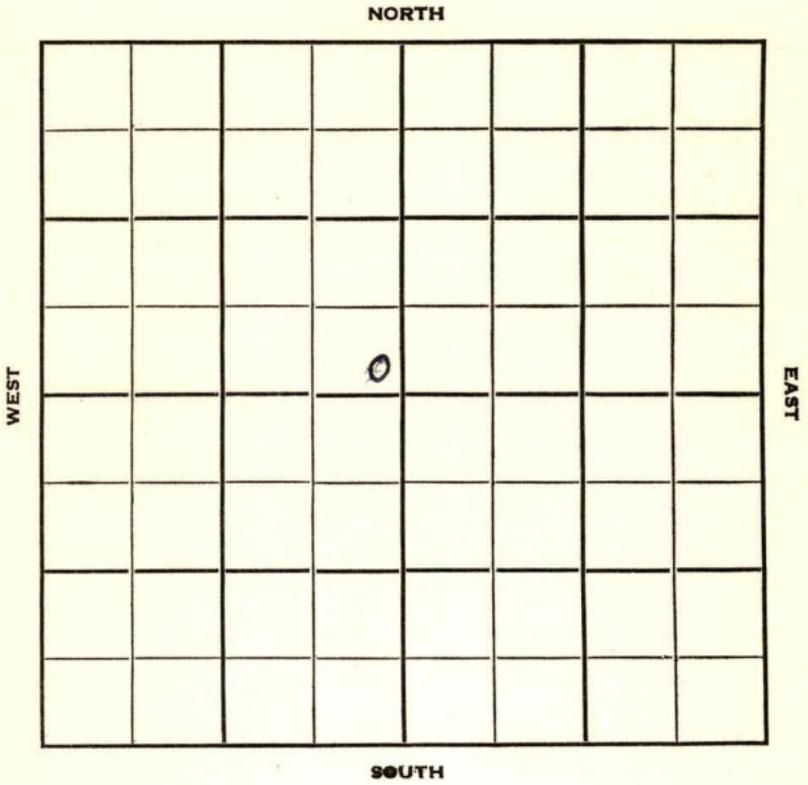

Sec. 11 Twp. 27 R. 33W

Well No. #1 Atkins Farm

National Assoc. Pet. Company

Transit Drlg. - Contr. Contractor

Hugoton Pool


         Ft. from N. Line

100' Ft. from S. Line

100' Ft. from E. Line

         Ft. from W. Line

SE NW

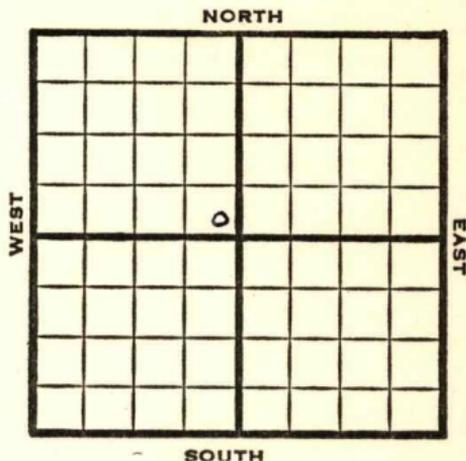

1950

**Elev. 2913'** REPORT

11/15

Spud 11-11-50  
8" @ 605'  
Drlg. 726'

1951

2/21

Spud 11-11-50  
Gas Well TD 2723  
8" @ 605' 5" @ 2698  
TD 2723 SP 2676  
240/2631-71 Her 2631  
**Krider 2649 Win 2698**  
18000 A Comp. 6, 870,000 gas

**COMPLETED**

County Haskell State Kansas

Sec. 11 (Blk. 2 Twp.) (Sur. 27 Rge.) 33W Map No.

Operator National Assee. Pet.

Well No. 1 Farm Atkins

Elev. \_\_\_\_\_ Location SE NW


100 Ft. From S Line NW

100 Ft. From E Line Quarter

NOV 15 1950

Ist. Report \_\_\_\_\_

Completion \_\_\_\_\_

Remarks \_\_\_\_\_

Transit Drlg. - Contr.

Spudding Date 11-11-50

Drlg. Data Hugoten Pool

8" © 605 drlg. 726

FIRST REPORT

