


Section 12 Township 27 Range 33-W

Well No. #1 Tate "B"

Company National Assoc. Pet.

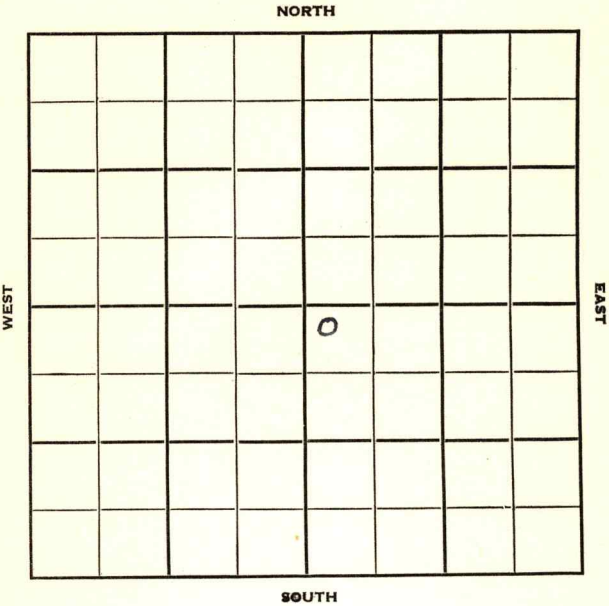

Haskell

KANSAS

Sec. 12 Twp. 27 R. 33W

Well No. #1 Tate "B" Farm

National Assoc. Pet. Company

Transit Drlg. - Contr. Contractor

Hugoton Pool


100' Ft. from N. Line

 Ft. from S. Line

 Ft. from E. Line

100' Ft. from W. Line

NW SE

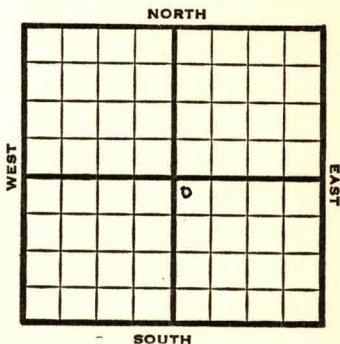

1950 Elev. 2904 REPORT

11/8 Spud 11-4-50
8" @ 602'
Drlg. 605'

1951

2/21 Spud 11-4-50
Gas Well TD 2707
8" @ 602 5" @ 2686 TD 2707
Her 2620 Krider 2638
Win 2687
312/2610-62 18,000 A
Comp. 5,440,000 gas 386#

COMPLETED

County Haskell State Kansas
Sec. 12 (Blk.) 27 (Sur.) 33W Map No.
Operator National Assoc. Pet.
Well No. 1 Farm Tate "B"
Elev. _____ Location NW SE

100 Ft. From N Line SE
100 Ft. From W Line Quarter
1st. Report NOV 8 1950
Completion _____
Remarks Transit Drlg. - Contr.
Spudding Date 11-4-50

Drlg. Data Hugoton Pool
8" @ 602 drlg. 605

County Haskell State Kansas
 Sec. 12 (Blk.) 27 (Sur.) 33W Map No.
 Operator National Assoc. Pet.
 Well No. 1 Farm Tate "B"
 Elev. 2904 Location NW SE



100 Ft. From N Line SE
100 Ft. From W Line Quarter

1st. Report

Completion FEB 21 1951

Remarks Hugoton Pool

Transit Drlg. - Contr.

Spudding Date 11-4-50

Drlg. Data Gas well TD 2707

8" @ 602 5" @ 2686 TD 2707 Her. 2620

Krider 2638 Win. 2687 312/ 2610-62

18000 A Comp. 5,440,000 gas 386#

J. E. TYRA