


KANSAS

Section 14 Township 27 Range 33-WWell No. #1 DavisCompany National Assoc. Pet.

NORTH

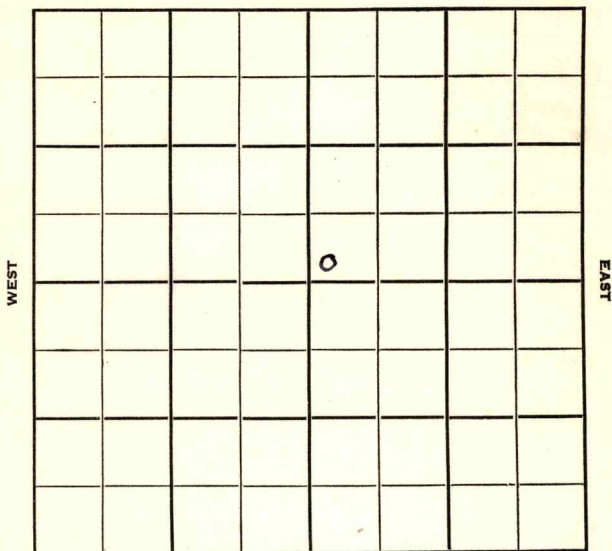

SOUTH

Haskell

KANSAS

Sec. 14 Twp. 27 R. 33W

Well No. #1 Davis Farm

National Assoc. Pet. Company

Ferrell Drlg. - Contr. Contractor

Hugoton Pool


Ft. from N. Line

100' Ft. from S. Line

Ft. from E. Line

100' Ft. from W. Line

SW NE

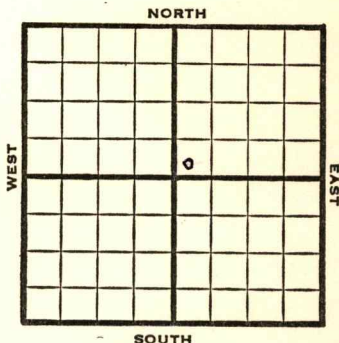

1950

Elev. 2913' REPORT

11/15

Spud 11-9-50
8" @ 603'
Drlg. 2290'

1951
2/21

Spud 11-9-50
Gas Well TD 2718
8" @ 603 5" @ 2698 TD 2718
Her. 2631 Krider 2648
Win. 2694
210/2634-69 22,000 A
Comp. 6, 785,000 gas 385#

COMPLETED

County Haskell State Kansas
 Sec. 14 (Blk.) 27 (Sur.) 33W Map No.
 Operator National Assoc. Pet.
 Well No. 1 Farm Davis
 Elev. 2913 Location SW NE

0

FIRST REPORT

100 Ft. From S Line NE
 100 Ft. From W Line Quarter
 1st. Report NOV 15 1950

Completion

Remarks

Ferrell Drlg. - Contr.

Spudding Date 11-9-50

Drlg. Data

Hugoton Pool

8" @ 603 drlg. 2290

J. E. TYRA

County Haskell State Kansas
 Sec. 14 (Blk.) 27 (Sur.) 33W Map No.
 (Twp.) (Rge.)
 Operator National Assoc. Pet.
 Well No. 1 Farm Davis
 Elev. 2913 Location SW NE

100Ft. From S Line NE
 100Ft. From W Line Quarter

1st. Report

Completion FEB 21 1951

Remarks Hugoton Pool

Ferrell Drlg. - Contr.

Spudding Date 11-9-50

Drlg. Data Gas well TD 2718
8" @ 603 5" @ 2698 TD 2718 Her. 2631
Krider 2648 Win. 2694 210/ 2634-69
22000 A Comp. 6,785,000 gas 385#

J. E. TYRA