


KANSAS

Section 16 Township 27 Range 33-WWell No. #1 Atkins "E"Company Cities Service
Hugoton

NORTH

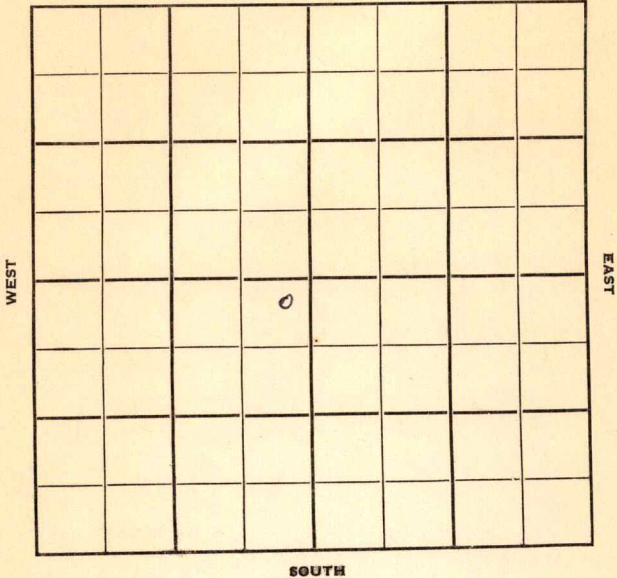

KANSAS

Haskell ✓

Sec. 16 Twp. 27 R. 33-W

Well No. #1 Atkins "E" Farm _____

Cities Service

Company

Hugoton Pool (Corbett & Barber ~~North~~ Contr.)


100 Ft. from N. Line

_____ Ft. from S. Line

100 Ft. from E. Line

_____ Ft. from W. Line

NE SW

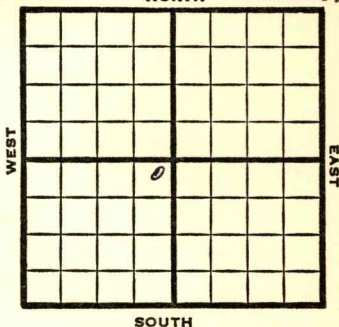

REPORT

1949

11/23

Location

11/29

"

12/7

8"@ 800'

TD 2783'

5"@ 2784'

12/14

380 shots 2616-2758'

12/21

"

12/28

"

1950

1/11

TD 2783'

8"@ 2785'

5"@ 2784'

Her 2592'

Kr 2614'

Win 2675'

15,500,000 CFGPD

Comp

COMPLETED

Map No. _____ Sec. 16 Twp. 27 R. 33W

Well No. 1 Atkins "E"

Cities Service _____ Company

Corbett & Barber _____ Contractor

NE SW


**FIRST REPORT
SECTION PLAT**

100 Ft. from N. Line

_____ Ft. from S. Line

100 Ft. from E. Line

_____ Ft. from W. Line

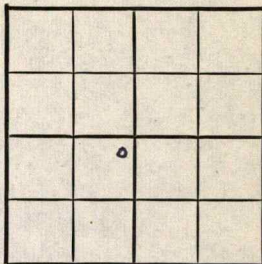

Haskell County

Location X

Rig up _____

Drilling and Remarks:

RECORD

Cased _____ in., _____ ft.

Sand _____

Gas _____

Oil _____

Total Depth _____

PRODUCTION

1st 24 hrs. Nat. _____

1st 24 hrs. after shot _____

Gas _____ Cu. Ft.

Dry Hole _____

Abandoned _____

Date

NOV 23 1949 19 S. J. LEWIS Scout

Kansas

Hugoton Pool

Map No. _____ Sec. 16 Twp. 27 R. 33WWell No. 1 Atikins "E"

Cities Service

Company

Contractor

NE SW

SECTION PLAT

	COMPLETE		
	o		

100 Ft. from N. Line Ft. from S. Line100 Ft. from E. Line Ft. from W. Line

Haskell County

Location _____

Rig up _____

Drilling and Remarks:

8" @ 2785

5" @ 2784

Ker 2592

Ker 2614

Win 2675

15,500.000

C F G P D

RECORD

Cased _____ in., _____ ft.

Sand _____

Gas _____

Oil _____

Total Depth _____

PRODUCTION

1st 24 hrs. Nat. _____

1st 24 hrs. after shot _____

Gas _____ Cu. Ft.

Dry Hole _____

Abandoned _____

Date

JAN 11

19

J. E. TYRA

Scout