

KANSAS

Haskell

Section 19 Township 27 Range 33-W

Well No. #1 Frey "C"

Company Columbian Fuel

Hugoton

NORTH

WEST

			0				

EAST

SOUTH

KANSAS

Haskell

Sec. 19 Twp. 27 R. 33W ✓


Well No. 1 Frey "C" Farm

Columbian Fuel

Company

Moran Contr. Hugoton Pool

NORTH

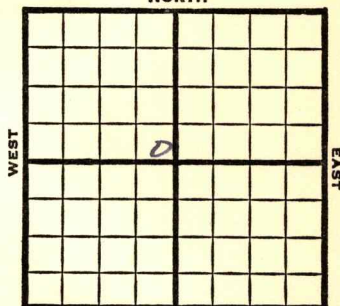

Ft. from N. Line

100

Ft. from S. Line

100

Ft. from E. Line

Ft. from W. Line

SE NW

SOUTH

1949

Elev 2989'

R E P O R T

7/27

S.H.

8/3

10" @ 600'

TD 2635'

7" @ 2627'

8/10

Drlg. 2738'

8/17

TD 2773'

153' of 5" Perf liner @ 2773

15,000 acid

8/24

"

8/31

TD 2773'

7" @ 2627'

153' of 5" Perf Liner @ 2773'

15000 acid

6,538,000 Gas

407# R Pr.

Comp

COMPLETED

Kansas

Hugoton Pool

Map No. _____ Sec. 19 Twp. 27 R. 33WWell No. 1 Frey "C"

Columbian Fuel

Company

Moran

Contractor

SE NW

FIRST REPORT
SECTION PLAT

_____ Ft. from N. Line

100 Ft. from S. Line100 Ft. from E. Line

_____ Ft. from W. Line

Haskell County

Location _____

Rig up _____

Drilling and Remarks:

S ~~A~~.

RECORD

Cased _____ in., _____ ft.

Sand _____

Gas _____

Oil _____

Total Depth _____

PRODUCTION

1st 24 hrs. Nat. _____

1st 24 hrs. after shot _____

Gas _____ Cu. Ft.

Dry Hole _____

Abandoned _____

Date

JUL 27 1949 19

S. J. LEWIS

Scout

Map No. ✓ Sec. 19 Twp. 27 R. 33W

Well No. 1 Frey "C"

Columbian Fuel

Company

COMPLETE

Contractor

SE NW

E1,2988
SECTION PLAT

Ft. from N. Line

100 Ft. from S. Line

100 Ft. from E. Line

Ft. from W. Line

Haskell County

RECORD

Location

Cased in., ft.

Rig up

Sand

Drilling and Remarks:

Gas

7" @ 2627

Oil

Total Depth 2773

153' of 5" Pay line

@ 2773

15000 acd

6,538,000 gal

407# R/P

PRODUCTION

1st 24 hrs. Nat.

1st 24 hrs. after shot

Gas Cu. Ft.

Dry Hole

Abandoned

Date

AUG 31 1949

19

S. J. LEWIS

Scout