


Section 21 Township 27 Range 33-W

Well No. #1 Davies

Company Cities Service
Hugoton Pool

NORTH

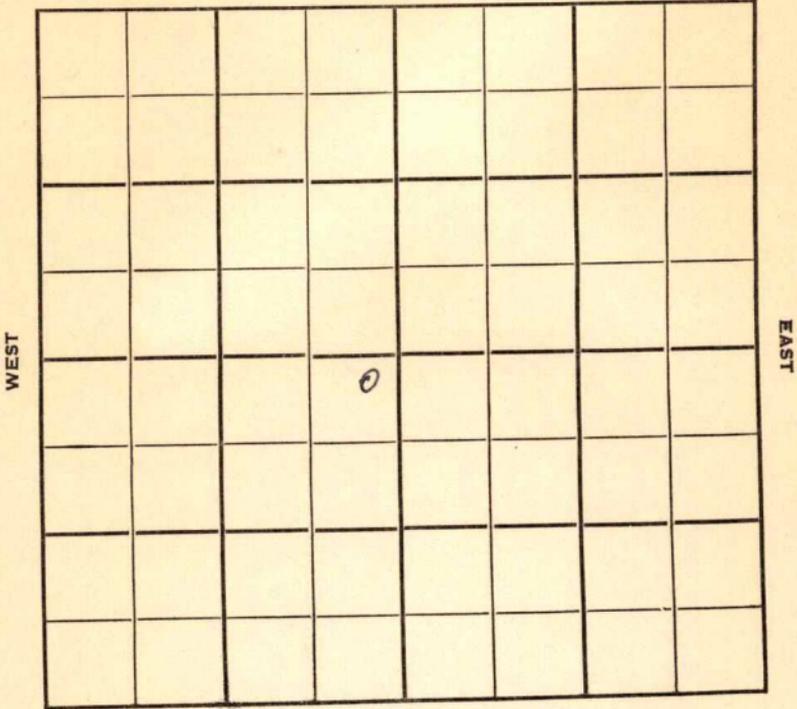

WEST

EAST

SOUTH

Haskell

KANSAS

Sec. 21 Twp. 27 R. 33W

Well No. #1 Davies Farm

Cities Service

Company

Hugoton Pool (Corbett & Barber, Contr.)


100' Ft. from N. Line

_____ Ft. from S. Line

100' Ft. from E. Line

_____ Ft. from W. Line

NE SW

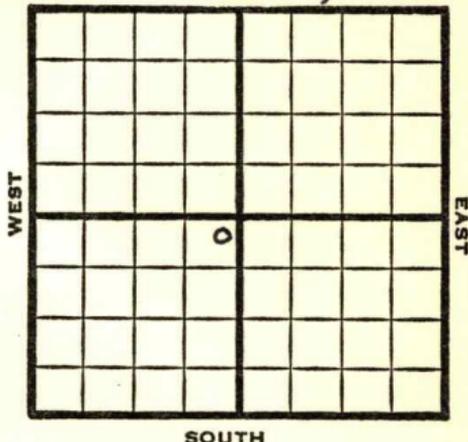

1949

REPORT

11/23 Location

11/29 RUR

12/7 8"@ 760'
TD 2815
5"@ 2814'

12/14 "

12/21 "

12/28 "

1950

2/1 TD 2815'
8"@ 760'
5"@ 2814'
Hev 2616'
Kr 2642'
Win 2702'
Tar 2752'
Perf 30/2768-70'
Perf 30/2754-60
Perf 90/2702-20
Perf 100/2660-80
Perf 50/2642-52
Used 25000 acid
8,260,000 CFGPD
Comp

COMPLETED

Map No. _____ Sec. 21 Twp. 27 R. 33W

Well No. 1 Davies

Cities Service Company

Corbett & Barber Contractor

NE SW

FIRST REPORT
SECTION PLAT

100 Ft. from N. Line

	o		

_____ Ft. from S. Line

100 Ft. from E. Line

_____ Ft. from W. Line

Haskell County

Location x

RECORD

Rig up _____

Cased _____ in., _____ ft.

Drilling and Remarks:

Sand _____

Gas _____

Oil _____

Total Depth _____

PRODUCTION

1st 24 hrs. Nat. _____

1st 24 hrs. after shot _____

Gas _____ Cu. Ft.

Dry Hole _____

Abandoned _____

Date

NOV 23 1949 19

S. J. LEWIS

Scout

Map No. _____ Sec. 21 Twp. 27 R. 33W

Well No. 1 Davies

Cities Service

Company

Contractor

NE SW

100 Ft. from N. Line

_____ Ft. from S. Line

100 Ft. from E. Line

_____ Ft. from W. Line

SECTION PLAT

COMPLETE		
	o	

Haskell County

Location _____

Rig up _____

Drilling and Remarks:

8"-760
 5" @ 2814
 Nov 2616
 Kr. 2642
 Win 2702
 Jan 2752
 (aver)

RECORD

Cased _____ in., _____ ft.

Sand _____

Gas _____

Oil _____

Total Depth 2815

PRODUCTION

1st 24 hrs. Nat. _____

1st 24 hrs. after shot _____

Gas _____ Cu. Ft.

Dry Hole _____

Abandoned _____

Date

FEB 1 1950

19

J. E. TYRA Scout

perf - 30/2768-70
" 30/2754-60
" 90/2702-20
" 100/2660-80
50/2642-52

used 25000 acid
8,260,000
@ FGPD

RECORD

FEB

1960

- Scout Cards *Scout*
- Land Small Map *Scout*
- Land Wall Map *Scout*
- Tracings
- France Map
- Pierce Map
- Misc.