

KANSAS

Section 23 Township 27 Range 33-WWell No. #1 CoxCompany National Assoc. Pet.

NORTH

				0			

WEST

EAST

SOUTH

Haskell

KANSAS

33W

Sec. 23 Twp. 27 R. 33W

Well No. #1 Cox Farm

National Assoc. Pet. Company

Ferrell Drlg. -Contr. Contractor

Hugoton Pool


Ft. from N. Line

100' Ft. from S. Line

Ft. from E. Line

100' Ft. from W. Line

SW NE

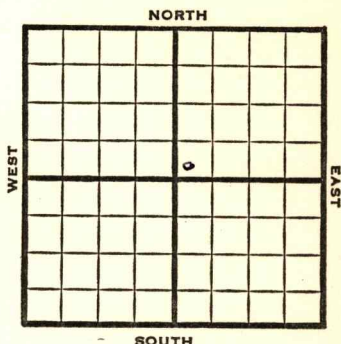

1950 Elev. 2910' REPORT

11/15 Spud 11-11-50
8" @ 602'
Drlg. 2135'

1951

2/21 Spud 11-11-50
Gas Well TD 2724
8" @ 602' 5" @ 2703
TD 2724 Her. 2637
Krider 2655 Win 2703
240/2638-78 24,000 A
Comp. 7,220,000 gas 376#

COMPLETED

J. E. TYRA

J. E. TYRA