


Section 25 Township 27 Range 33-W

Well No. #1 Batman

Company National Assoc. Petr.

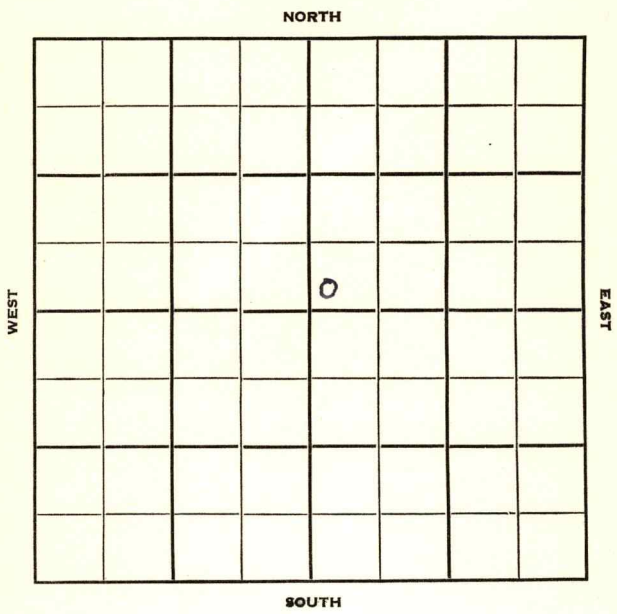

Haskell

KANSAS



Sec. 25 Twp. 27 R. 33W

Well No. #1 Batman Farm

National Assoc. Pet.

Company

Ferrell Drlg. - Contr.

Contractor

Hugoton Pool

Ft. from N. Line

100'


Ft. from S. Line

Ft. from E. Line

100'

Ft. from W. Line

SW NE

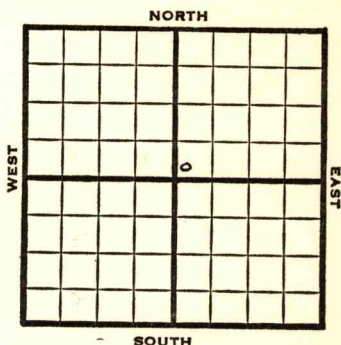

1950	Elev. 2932'	REPORT
11/8	Spud 11-1-50 10" @ 602' Drlg. 2470'	
1951		
2/21	Spud 11-1-50 Gas Well TD 2760 10" @ 602 5" @ 2727 TD 2760 Her 2659 Krider 2676' Win 2725 258/2659-2707 20,000 A Comp. 7,895,000 gas 375#	
	COMPLETED	

County Haskell State Kansas
 Sec. 25 (Blk. 27 (Sur. 33W Map No.
 (Twp.) (Rge.)
 Operator National Assoc. Pet.
 Well No. 1 Farm Batman
 Elev. Location SW NE

FIRST REPORT
0

100 Ft. From S Line NE
100 Ft. From W Line Quarter
 1st. Report NOV 8 1950

Completion

Remarks

Ferrell Drlg. - Contr.

Spudding Date 11-1-50

Drlg. Data

Hugoton Pool

10" @ 602 drlg. 2470

J. E. TYRA

County Haskell

State Kansas

Sec. 25 (Blk. Twp.) 27 (Sur. Rge.) 33W Map No.

Operator National Assoc. Pet.

Well No. 1 Farm Batman

Elev.	2932	Location	SW NE
-------	------	----------	-------

100 Ft. From S Line NE

100 Ft. From W Line Quarter

1st. Report

Completion FEB 21 1951

Remarks	Hugoton Pool
---------	--------------

Ferrell Drlg. - Contr.

Spudding Date 11-1-50

Drlg. Data Gas well TD 2760

10" @ 602 5" @ 2727 TD 2760 Her. 2659

Krider 2676 Win. 2725 258/ 2659-2707

20000 A Comp. 7,895,000 gas 375#

J. E. TYRA