


Section 26 Township 27 Range 33-W

Well No. #1 Batman "B"

Company National Assoc. Pet.

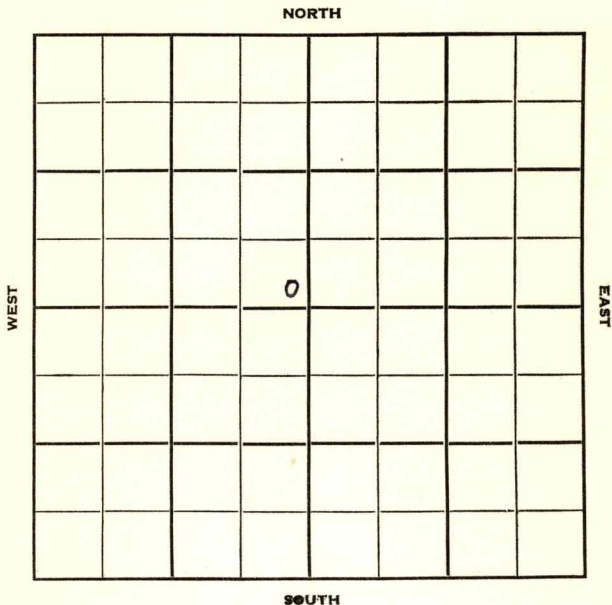

Haskell

KANSAS

Sec. 26 Twp. 27 R. 33W

Well No. #1 Batman "B" Farm

National Assoc. Pet. Company

Hugoton Pool Contractor


 Ft. from N. Line

100' Ft. from S. Line

100' Ft. from E. Line

 Ft. from W. Line

SE NW

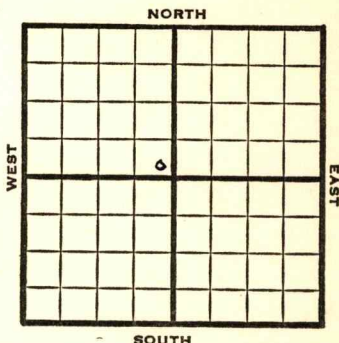

1950

Elev. 2942' REPORT

11/15

Spud 11-2-50

8" @ 600'

Drlg. 2400'

5/29

Spud 11-2-50

Gas Well TD 2775

8" @ 600 5" @ 2753

TD 2775 SP 2737

252/2690-2732 **Her. 2689**

Krider 2706 Win. 2752

31,500 A Comp. 5,440,000 gas

COMPLETED

County Haskell State Kansas

Sec. **26** (Blk. Twp.) **27** (Sur. Rge.) **33W** Map No.

Operator National Assoc. Pet.

Well No. 7 Farm Batman "B"

Elev. 2942 Location SE NW

100 Ft. From S Line NW

100 Ft. From E Line Quarter

1st. Report NOV 15 1950

Completion

Remarks

Spudding Date 11-2-50

Drig. Data Hugoton Pool

8" @ 600 drlg. 2400

J. E. TYRA

(Blk.)
(Twp.)

National Assoc. Pet.

1 Farm Batman "B"

2942	Location	SE NW
------	----------	-------

COMPLETE

100 Ft. From S Line NW

100 Ft. From E Line Quarter

1st. Report

MAY 29 1951

Hugoton Pool

11-2-50

Gas well TD 2775

8" @ 600 5" @ 2753 TD 2775 SP 2737

252/ 2690-2732 Her. 2689 Krider 2706

Win. 2752 31500 A Comp. 5,440,000 gas

J. E. TYRA