


Haskell

Section 32 Township 27 Range 33W

Well No. 1 Roy

Company Huber Corporation

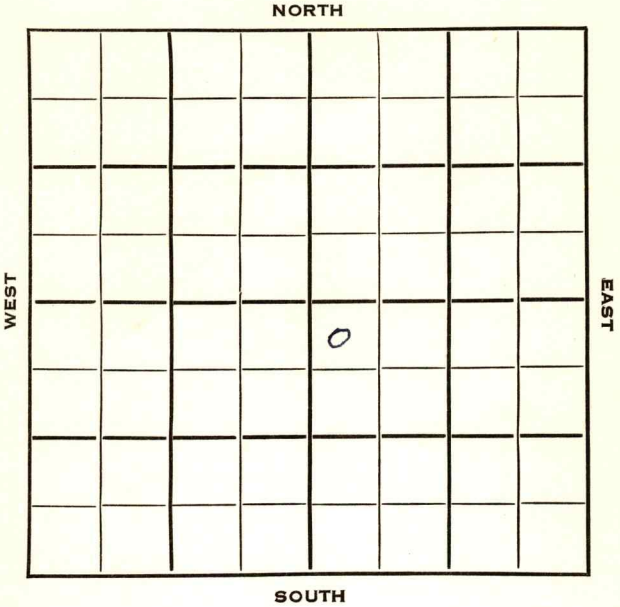

Sec. 32 Twp. 27 R. 33 W

Well No. # 1 Roy Farm _____

Huber Corp. Company _____

Contractor _____


150 Ft. from N. Line

_____ Ft. from S. Line

_____ Ft. from E. Line

150 Ft. from W. Line

NW SE

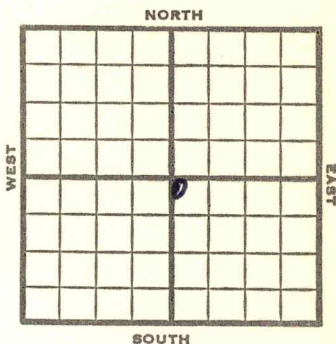

1953 **Elev. 2994'** REPORT

1/21 Spud 1-18-53
8" @ 612

Drlg. 1075'

1/29 **Her 2677' Up Kr 2706' Low Kr 2718**
RTD 2725' 5" @ 2723 CO

2/5 CO 2736
1000A

PB 2718

66/2701-12, 15,000A

2/12 NR

2/19 "

2/25 Spud 1-18-53
Gas Well

TD 2736

8" @ 612

Her 2677, Kri 2706,

TD 2725

5" @ 2723, CO to 2736, 1000A

PB 2718, 66/2701-12, 15000A

Comp. 2,100,000 gas

COMPLETED

County Haskell State Kansas

Sec. 32 (Blk. 27 (Sur. 33W (Twp.) (Rge.) Map No.

Operator Huber Corp.

Well No. 1 Farm Roy

Elev. 2994 Location NW SE

150 Ft. From N Line SE

150 Ft. From W Line Quarter

1st. Report

Completion FEB 25 1953

Remarks

Spudding Date 1-18-53

Drig. Data Gas well TD 2736

8" @ 612 Her. 2677 Kri. 2706

TD 2725 5" @ 2723 CO to 2736

1000 A PB 2718 66/ 2701-12

15000 A Comp. 2,100,000 gas

RAM