


Haskell

Section 35 Township 27 Range 33W

Well No. #1 E. Hawes

Company National Assoc. Pet.

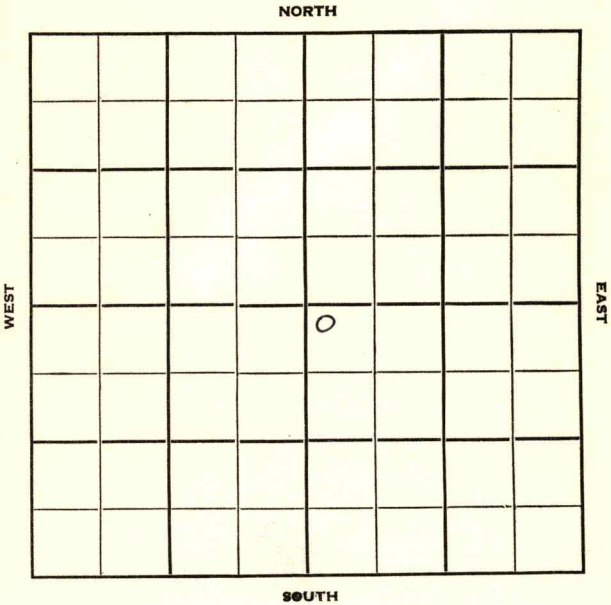

Haskell

KANSAS

Sec. 35 Twp. 27 R. 33W

Well No. #1 E. Hawes Farm

National Assoc. Pet. Company

Ferrell Drlg. - Contr. Contractor

Hugoton Pool


100' Ft. from N. Line

 Ft. from S. Line

 Ft. from E. Line

100' Ft. from W. Line

NW SE

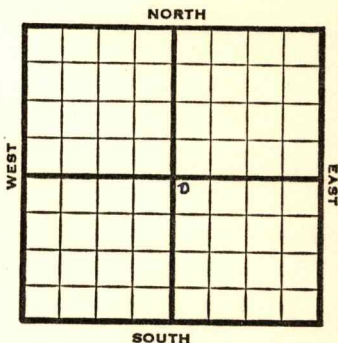

1950

Elev. 2948' REPORT

11/29

Spud 11-16-50

8" @ 600'

Win 2778'

TD 2779'

5" @ 2778'

4/4

Spud 11-16-50

Gas Well TD 2798

8" @ 600'

Win. 2778 TD 2798

5" @ 2778

Her. 2704 Krider 2731

Win. 2778

22,000 A Comp. 8,500,000 gas 395#

COMPLETED

Haskell

State Kansas

Sec. **35** (Blk. **27** (Sur. **33W** Map No.

Operator National Assoc. Pet.

Well No. **1** Farm **E. Hawes**

[illegible]

FIRST REPORT

100 Ft. From N Line SE

100 Ft. From W Line Quarter

1st. Report NOV 29 1950

Completion

Remarks

Ferrell Drlg. - Contr.

Spudding Date 11-16-50

Drlg. Data Hugoton Pool

8" @ 600 Win. 2778 TD 2779 5" @ 2778

County

Haskell

State

Kansas

Sec.

35

(Blk.)
(Twp.)

27 (Sur.)
(Rge.)

3.3W

Map No.

Operator

National Assoc. Pet.

Well No.

1

Farm

E. Hawes

Elev.

2948

Location

NW SE

COMPLETE

100 Ft. From N Line SE

100 Ft. From W Line Quarter

1st. Report

Completion

APR 4 1951

Remarks

Hugoton Pool

Ferrell Drlg. - Contr.

Spudding Date

11-16-50

Drlg. Data

Gas well

TD 2798

8" @ 600

Win. 2778

TD 2798

5" @ 2778

Her. 2704

Krider 2731

Win. 2778

22000 A

Comp. 8,500,000 gas

395#

J. E. TYRA