

Section

36

Township

27

Range


33-W

Well No.

#1 Yount

Company

National Assoc. Pet.

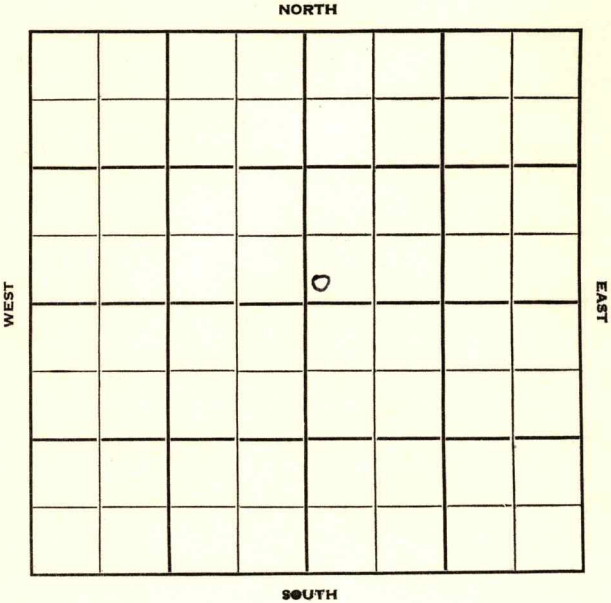

Haskell

KANSAS

Sec. 36 Twp. 27 R. 33W ✓

Well No. #1 Yount Farm

National Assoc. Pet.

Company

Contractor

Hugoton Pool


 Ft. from N. Line

100' Ft. from S. Line

100' Ft. from E. Line

 Ft. from W. Line

SW NE

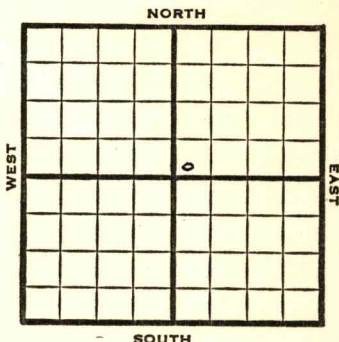

1950

Elev. 2935'

REPORT

11/15 Spud 10-26-50
Loo.

1951

2/21 Spud 10-26-50

Gas Well TD 2780

8" @ 599' 5" @ 2759

TD 2780 Her 2679


Krider 2700 Win 2749

264/2724-80 23,500 A

Comp. 8,200,000 gas 392#

COMPLETED

County Haskell State Kansas
 Sec. 36 (Blk. 27 (Sur. 33W Map No.
 (Twp.) (Rge.)
 Operator National Assoc. Pet.
 Well No. 1 Farm Yount
 Elev. 2935 Location SW NE

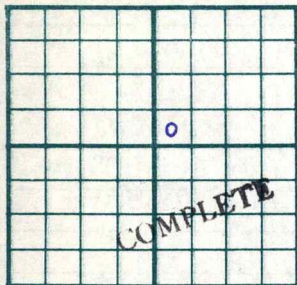

100 Ft. From S Line NE
100 Ft. From W Line Quarter

1st. Report

Completion FEB 21 1951

Remarks Hugoton Pool

Spudding Date 10-26-50

Drlg. Data Gas well TD 2780

8" @ 599 5" @ 2759 TD 2780 Her. 2679

Krider 2700 Win. 2749 264/ 2724-80

23500 A Comp. 8,200,000 gas 392#

J. E. TYRA