


Map No. 1-33 Sec. 33 Twp. 27 R. 8W
 Well No. 1-33 Farm Lauck et al
 Company Lauck et al

NORTH

WEST

EAST

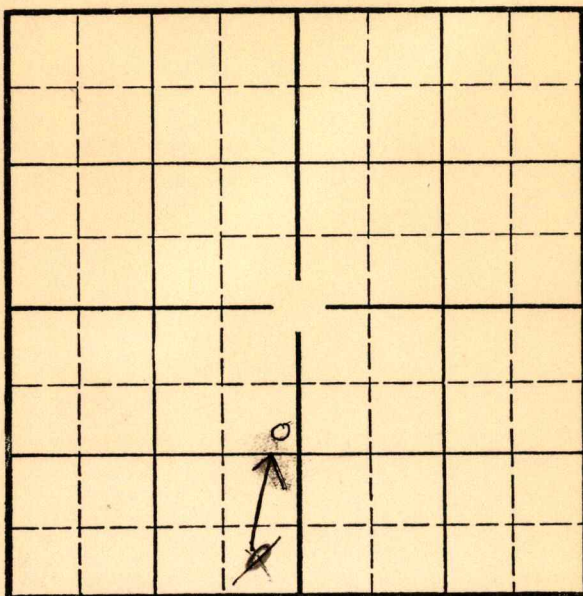

SOUTH

O. W. D. D

Location _____
 Drilling Remarks _____

Rig Up _____
 Drilling Remarks _____

RECORD

Cased _____ in. _____ ft.
 Sand _____
 Gas _____
 Oil _____
 Total Depth _____

PRODUCTION

1st 24 hrs. Nat. _____
 1st 24 hrs. after shot _____
 Gas _____ cu. ft. _____
 Dry Hole _____
 Abandoned _____

Kingman 8W

Map No. Sec. 33 Twp. 27 R.

Well No. 1- Skelling Farm
Lauch et al Company


990 Ft. from N. Line

330 Ft. from S. Line

330 Ft. from E. Line

 Ft. from W. Line

Elev. ~~XXXX~~ 1613

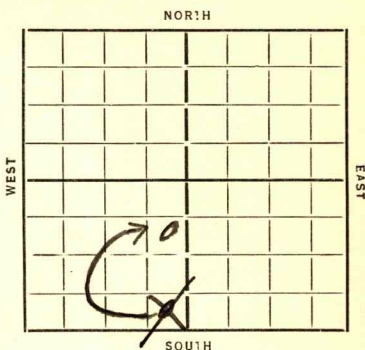

Date	REPORT	O.W.D.D
1935		
9/4	Location	
10/3	alg 1490	
10/10	H 2101 4032	
11/1	Top Chet 4017 8" 4018	
	TD 4022	
	Top Lang 3370 Rust	
11/7	11/14	
11/21	Top Chet 4032 (Corrected)	
	Wte 4049-56	
	SD 4161	
11/29	alg 4090	
12/6	Base Miss 4166	
	TD 4175 Ring 6" H.F.W.	
12/13	Base Miss 4166	
	3 Bailer Wte 4304-12	
	T Vials 4332	
	AO 4332-33	
	alg 4356	
12/19	Land 4376-4420 HFW 4376	
	HFW 4432-37 5" 4437	
	alg 4456	

OVER

12/26 seg tools 4471

1/2/36 Top Sil 4438 TD
u R 5"

1/8 Sil 4488
TD 4496 HFW
D & A.

ABANDONED

1936 O. W. D. D
1/29 OTD 4496
Sil 4488
TD 4583
D & A.

FIRST REPORTS

▽
ABANDONED

Map No. 36 Sec. 33 Twp. 27 R. 8W

Well No. 1- Spelling

Lauck et al Company

Contractor

Cudd

SECTION PLAT

990 Ft. from N. Line

..... Ft. from S. Line

330 Ft. from E. Line

..... Ft. from ~~W.~~ W. Line

ABANDONED

Location.....

Rig up.....

Drilling and Remarks:

OTd 4496
Sil. 4488
4583 Td

N. & A

RECORD

Cased..... in., ft.

Sand.....

Gas.....

Oil.....

Total Depth.....

PRODUCTION

1st 24 hrs. Nat.....

1st 24 hrs. after shot.....

Gas..... Cu. Ft.

Dry Hole.....

Abandoned.....

Date

1-29-36 192.....

ORVAL MANNSCHRECK

Scout

Map No. 36 Sec. 33 Twp. 27 R. 8W

Well No. 1- Skelling

Loft et al Company

Lauck Contractor

FIRST REPORTS

SECTION PLAT

..... Ft. from N. Line

330 Ft. from S. Line

330 Ft. from E. Line

..... Ft. from W. Line

Location.....

Rig up.....

Drilling and Remarks:

Loc

RECORD

Cased..... in., ft.

Sand.....

Gas.....

Oil.....

Total Depth.....

PRODUCTION

1st 24 hrs. Nat.....

1st 24 hrs. after shot.....

Gas..... Cu. Ft.

Dry Hole.....

Abandoned.....

Date

9-4-35 192.....

ORVAL MANNSCHRECK

Scout

KANSAS

Map No. 36 Sec. 33 Twp. 27 R. 8^W

Well No. 1- Skelling
Lauk et al Company

Contractor

SECTION PLAT

CORRECTION

990 Ft. from N. Line

..... Ft. from S. Line

330 Ft. from E. Line

..... Ft. from W. Line

CORRECTION

Location.....

Rig up.....

Drilling and Remarks:

*formerly reported
as DE SW*

CORRECTION

RECORD

Cased.....in.,ft.

Sand.....

Gas.....

Oil.....

Total Depth.....

PRODUCTION

1st 24 hrs. Nat.....

1st 24 hrs. after shot.....

Gas.....Cu. Ft.

Dry Hole.....

Abandoned.....

Date

9-12-35 192 O. Manschreck Scout

Map No. 36 Sec. 33 Twp. 27 R. 8W

Well No. 1 - Skelling

Lauk et al Company

Contractor

SECTION PLAT

990 Ft. from N. Line

Ft. from S. Line

330 Ft. from E. Line

Ft. from W. Line

COMPLETED

Location

Rig up

Drilling and Remarks:

hfw

D. & A.

RECORD

Cased in, ft.

Sand Sil 4488

Gas

Oil

Total Depth 4496

PRODUCTION

1st 24 hrs. Nat.

1st 24 hrs. after shot

Gas Cu. Ft.

Dry Hole

Abandoned

Date

JAN 8 1936

192

ORVAL MANNSCHRECK

Scout