

Haskell


KANSAS

SECTION 33 TOWNSHIP 27 RANGE 32 W

WELL NO. #1 Lemon

COMPANY Michaelis Drlg.

NORTH

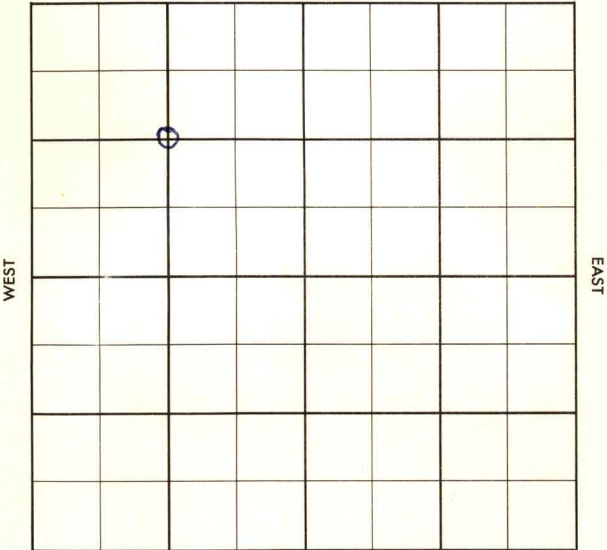

SOUTH

Haskell

KANSAS

SEC.	TWP.	R.
33	27	32W

WELL NO.

#1 Lemon

FARM

COMPANY

Michaelis Drlg.

CONTRACTOR

Co. tools

Hugoton


Ft. from N. Line

Ft. from S. Line

Ft. from E. Line

Ft. from W. Line

C NW 1/4

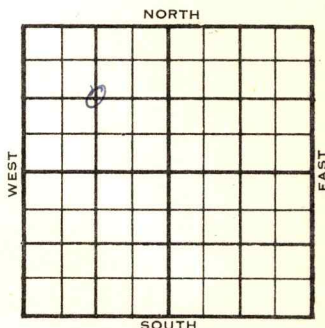

1956

ELEVATION

2917

REPORT

1-5

Comm. 12-28-55

8" @ 527/300

TD 2780

5" @ 2779/400

1-25

CO to 2766

PB 2758, 40/ 2742-52, 40/ 2718-28, ###
frac, open flow 3,326 mcg,

Comp. 8,430 mcfgpd, 412#

Log tops: U.Kri 2705

L. Kri. 2740

Winf 2778

TD 2780'

COMPLETED

County Haskell Elev. 2917
Sec. 33 Twp. 27 Rge. 3 2W
Company Michaelis Drlg.
Farm Name Lemon No. 1

TOPS	DEPTH	LOG	DATUM	Loc. in Sec.
Anh.				<u>C NW/4</u>
TP.				
H.				
Tr.				
Dg.				
BL.				
L.				Geol.
K.C.				
B.K.C.				Contr.
Ce.				<u>Co. tools</u>
C.				
M.				Pool
M.				<u>Hugoton</u>
K.				FIRST REPORT JAN 5 '66
Mz.				
Me.				
V.				
S.				
S.				
A.				
R.				
Pe.				
G.				
T.D.				

Date Comm. 12-28-55
8" @ 527/300 TD 2780 5" @ 2779/400

55

County Haskell Elev. 2917
 Sec. 33 Twp. 27 Rge. 32W
 Company Michaelis Drlg.
 Farm Name Lemon No. 1

TOPS	DEPTH	LOG	DATUM
Anh.			
TP.			
H. <u>U. Kri</u>		<u>2705</u>	
Tr. <u>"</u>		<u>2740</u>	
Dg. <u>Wing</u>		<u>2778</u>	
BL.			
L.			
K.C.			
B.K.C.			
Ce.			
C.			
M.			
M.			
K.			
Mz.			
Mq.			
V.			
S.			
S.			
A.			
R.			
PE.			
G.			
TD.	<u>2780</u>		

Loc. in Sec.

C NW/4

Geol.

Contr.

Co. tools

Pool

Hugoton

COMPLETE

Date Comm.

12-28-55

JAN 2 5 1956

8" @ 527/300

TD 2780

5" @ 2779/400

CO to 2766

PB 2758

40/ 2742-52

40/ 2718-28

frac

open flow 3,326 mcfg

Comp. 8,430 mcfgpd

412#