FORM 51 25M 3-49 PETROL

KANSAS

Grant

Section 33 Township 27 Range 35-W

Well No. #1 C L Ladner "B"

Company Columbian Fuel

Hugoton Pool

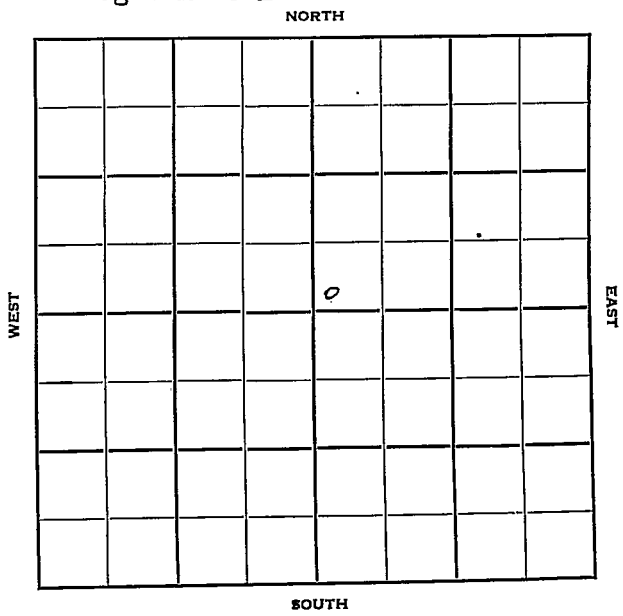

FORM 252-B
10M 9-49 PETROL

Grant

KANSAS

Sec. 33 Twp. 27 R. 35W

Well No. #1 C. L. Ladner "B" Farm

Columbian Fuel Company

Contractor

Hugoton Pool

Ft. from N. Line

100'

Ft. from S. Line

Ft. from E. Line

100'

Ft. from W. Line

SW NE

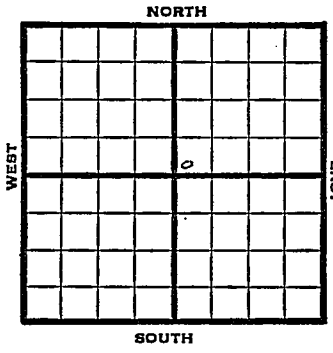

1950	Elev 3078 REPORT
3/8	Spud 3-4-50 10" @ 560' Drlg. 650'
5/17	TD 2810 10" @ 560 7" @ 2610 Hev 2591 Kr 2640 Win 2681 open flow 8,248,000 CFGPD Completed
	COMPLETED

Form 26 200 Bks. 11-49 Petrol

Kansas

Hugoton Pool

Map No. _____ Sec. 33 Twp. 27 R. 35W

Well No. 1 C. L. Ladner "B"

Columbian Fuel Company

Contractor

SW NE

SECTION PLAT

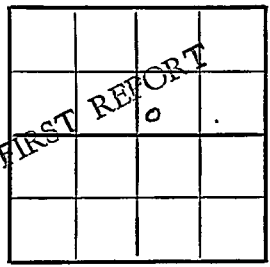

_____ Ft. from N. Line

100 Ft. from S. Line

_____ Ft. from E. Line

100 Ft. from W. Line

Grant County

Location _____

Rig up _____

Drilling and Remarks:

Spud 3-4-50

10" @ 560

drlg. 650

RECORD

Cased _____ in., _____ ft.

Sand _____

Gas _____

Oil _____

Total Depth _____

PRODUCTION

1st 24 hrs. Nat. _____

1st 24 hrs. after shot _____

Gas _____ Cu. Ft.

Dry Hole _____

Abandoned _____

Date

MAR 8 1950 19 J. E. TYRA Scout

Form 26 200 Bks. 11-49 Petrol

Kansas

Hugoton Pool

Map No. _____ Sec. 33 Twp. 27 R. 35W

Well No. 1 C. L. Ladner "B"

Columbian Fuel Company

Contractor

SW NE

El. 3078

SECTION PLAT

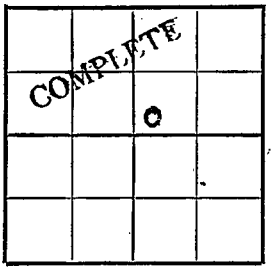

_____ Ft. from N. Line

100 Ft. from S. Line

_____ Ft. from E. Line

100 Ft. from W. Line

Grant

Location _____

Rig up _____

Drilling and Remarks:

10" @ 560

7" @ 2610

Her 2591

Kr. 2640

Win 2681

Openflow

8,248.000 CFGPD

RECORD

Cased _____ in., _____ ft.

Sand _____

Gas _____

Oil _____

Total Depth 2810

PRODUCTION

1st 24 hrs. Nat. _____

1st 24 hrs. after shot _____

Gas _____ Cu. Ft.

Dry Hole _____

Abandoned _____

Date MAY 17 1950

19 J. E. TYRA Scout