

KANSAS

Haskell County

FORM 51 IOM 12-46 PETROL

Section 33 Township 27 Range 34-W

Well No. 1 Alexander "A"


Company Cities Service

Hugoton Pool

NORTH

WEST

EAST

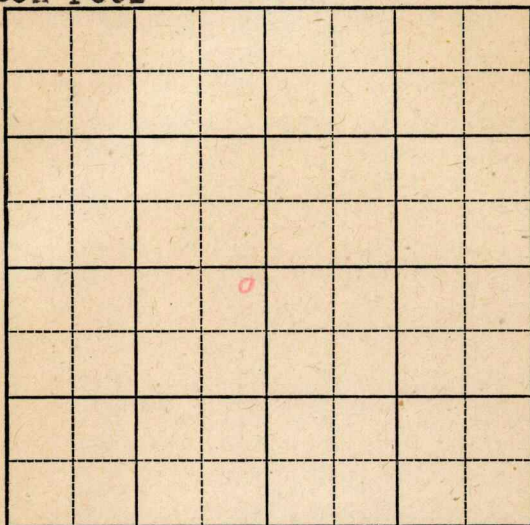

SOUTH

KANSAS

Haskell County ✓

Sec. 33 Twp. 27 R. 34W

Well No. 1 Alexander "A" Farm

Cities Service Company

Hugoton Pool


100 Ft. from N. Line

 Ft. from S. Line

100 Ft. from E. Line

 Ft. from W. Line

NE SW

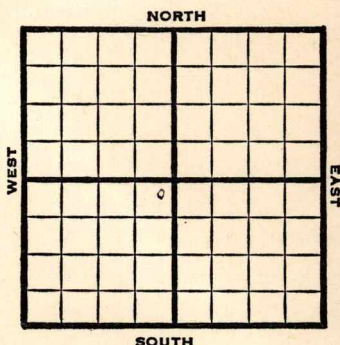

1947 **Elev. 3047'** REPORT

7-16	Loc.
7/22	8" @ 800 Drlg. 2073
7/29	TD 2769-5" @ 2768' Acid
8/6	95 shots 2727-46 60 shots 2708-20 90 shots 2662-80 90 shots 2622-40 40 shots 2600-08'
8/13	42000 acid
8/20	" "
8/27	" "
9/3	" "
9/10	5" @ 2768' Perf. 29,000 acid 14 M Gas 389# R. Pr. TD 2769'

COMPLETED

Map No. _____ Sec. 33 Twp. 27 R. 34W

Well No. 1 Alexander "A"

Cities Service _____ Company

FIRST REPORT _____ Contractor

NE SW


SECTION PLAT

100 Ft. from N. Line

_____ Ft. from S. Line

100 Ft. from E. Line

_____ Ft. from W. Line

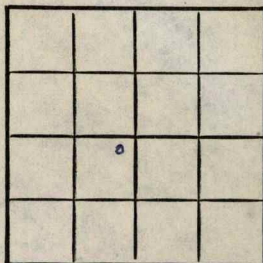

Haskell County

Location X

Rig up _____

Drilling and Remarks:

RECORD

Cased _____ in., _____ ft.

Sand _____

Gas _____

Oil _____

Total Depth _____

PRODUCTION

1st 24 hrs. Nat. _____

1st 24 hrs. after shot _____

Gas _____ Cu. Ft.

Dry Hole _____

Abandoned _____

Date

JUL 16 1947

19

S. J. LEWIS

Scout

