


DX 78-1 Haskell

KANSAS

Section 5 Township 27S Range 34W

Well No. #25 Curry Jones

Company Helmerich & Payne

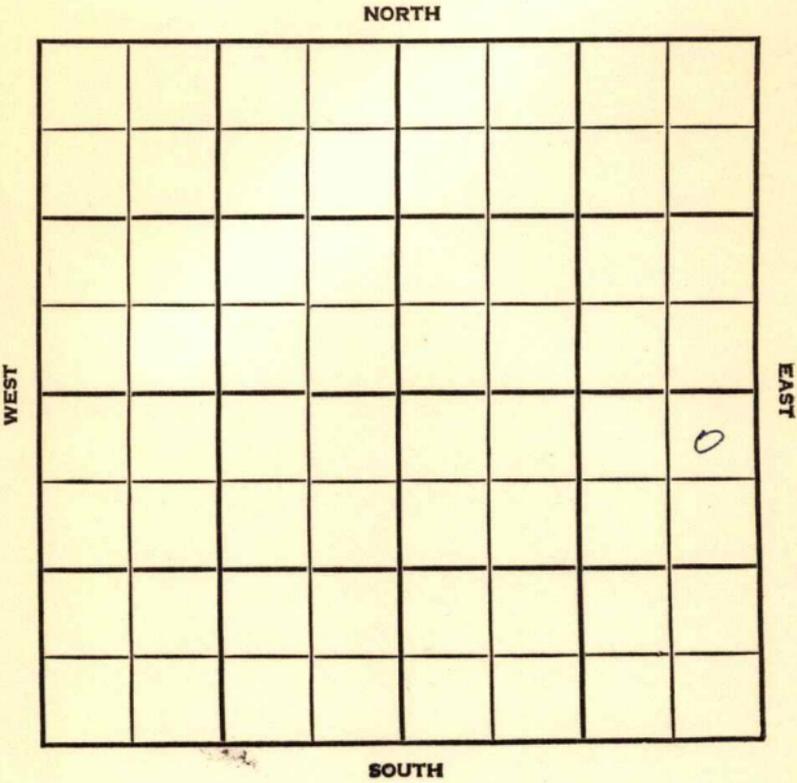

Haskell

KANSAS


SEC. 5	TWP. 27	R. 34W
-----------	------------	-----------

WELL NO. #25 Curry Jones FARM

COMPANY Helmerich & Payne

CONTRACTOR Pleasant-Prairie

\_\_\_\_\_ FT. FROM N. LINE  
 \_\_\_\_\_ FT. FROM S. LINE  
 \_\_\_\_\_ FT. FROM E. LINE  
 \_\_\_\_\_ FT. FROM W. LINE

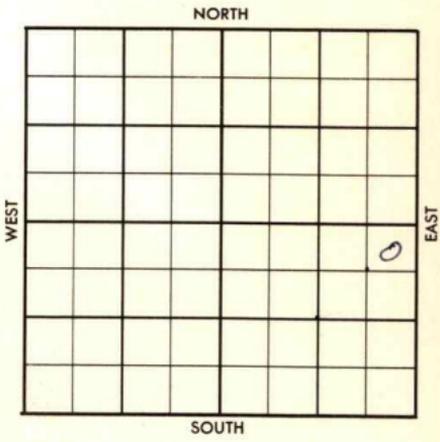

NE NE SE

1956	ELEVATION	REPORT
------	-----------	--------

7-25 Location

**COMPLETED**

County Haskell Elev. \_\_\_\_\_  
 Sec. 5 Twp. 27S Rge. 34W  
 Company Helmerich & Payne  
 Farm Name Curry Jones No. 25

TOPS	DEPTH	LOG	DATUM
Anh.			
Tp.			
H.			
Tr.			
Dg.			
Bl.			
L.			
K.C.			
B.K.C.			
Ce.			
C.			
M.			
M.			
K.			
Mz.			
Mq.			
V.			
S.			
S.			
A.			
R.			
Pe.			
G.			
T.D.			

Loc. in Sec. NE NE SE

Geol. \_\_\_\_\_

Contr. \_\_\_\_\_

Pool Pleasant  
Prairie

FIRST REPORT

JUL	25		1956

Date Comm. \_\_\_\_\_ Loc. \_\_\_\_\_

*Handwritten red mark resembling '35'*

JUL 1 1956

R.O.

Co.  
Lse.  
No.  
Sec.  
T.  
R.

County Haskell Elev. 2786  
 Sec. 5 Twp. 27S Rgs. 34W  
 Company Helmerich & Payne  
 Farm Name Curry Jones No. 25

TOPS	DEPTH	LOG	DATUM	Loc. in Sec.
Anh.				NE NE SE
Top.		3489		
H.		3857		
Tr.		3870		
Dg.				
Bl.				
L.		3903		Geol.
K.C.				Contr.
B.K.C.				
Co. <u>Marm</u>		4470		
C.C.		4682		
M.	4985			
M. <u>Atok</u>		4864		Pool Pleasant
K. <u>Musk</u>		4924		Prairie
Nz. <u>" sd</u>		5008-23		
M. <u>Miss</u>		5023		
V.				
S.				
S.				
A.				
R.				
Pe.				
G.				
TD.	5176			

COMPLETE  
 SEP 12 '56

Date Comm. LOC. AUG 1 '56  
AUG 8 '56 AUG 15 '56 8-4-56 10"  
@ 812/500 @ 3500 AUG 22 '56  
@ 4950 AUG 29 '56 5 1/2 @ 5175/500  
SEP 5 '56 CO 24/5121-27 1/2 @  
note 20 Boph no/w PB  
40/5060-70 @ 1 1/2 Boph no/w  
SEP 12 '56 \$ 85 Boph no/w 3 1/2 hrs  
PB 5090? Pop Ph P. 192  
Boph no/w est 35°