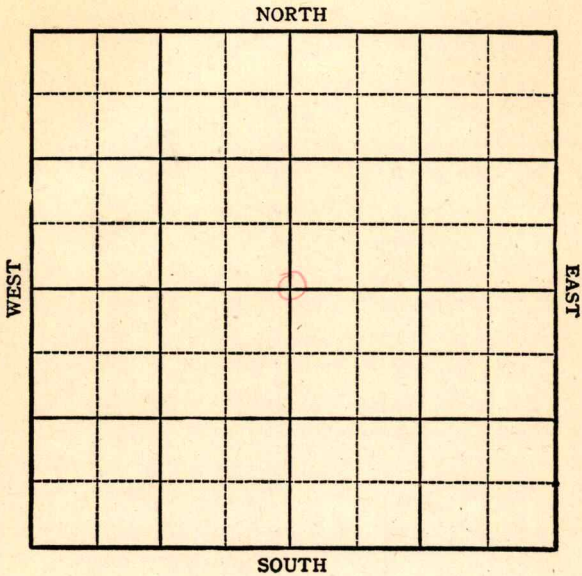


KANSASSection 6 Township 27 Range 34WWell No. #2 CurryCompany Helmerick & Payne

KANSAS

Haskell

Sec. 6 Twp. 27 R. 34WWell No. #2 Curry FarmHelmerick & Payne Company

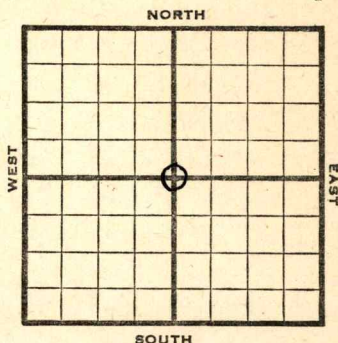
Hugoton

2640 Ft. from N. Line

Ft. from S. Line

2640 Ft. from E. Line

Ft. from W. Line

C Sec. Elev. 3005

## 1944 R E P O R T

12/6 Location

12/14 "

12/21 "

12/29 "

1945

1/3 RUR

1/10 10" @ 740  
Holenberg 2385  
Drlg 2575

1/17 " " "

1/26 7" @ 2648  
TD 2650 RUST

1/31 " " "

2/7 " " "

2/14 " " "

2/21 " " "

2/28 10,000 acid 5 M gas

3/7 66 shots 2522-2678 8000 acid

3/14 " " " " " "

3/23 " " " " " "

3/29 " " " " " "

4/5 " " " " " "

4/12 2000 acid.

4/20 " "

OVER

1945

|       |                    |   |
|-------|--------------------|---|
| 4/27  | 2000 acid.         |   |
| 5/3   | "                  | " |
| 5/10  | "                  | " |
| 5/17  | "                  | " |
| 5/24  | "                  | " |
| 5/31  | "                  | " |
| 6/8   | "                  | " |
| 6/14  | "                  | " |
| 6/21  | "                  | " |
| 6/28  | "                  | " |
| 7/3   | "                  | " |
| 7/11  | "                  | " |
| 7/19  | "                  | " |
| 7/26  | "                  | " |
| 8/1   | "                  | " |
| 8/8   | "                  | " |
| 8/15  | "                  | " |
| 8/22  | "                  | " |
| 8/29  | "                  | " |
| 9/5   | "                  | " |
| 9/12  | "                  | " |
| 9/19  | "                  | " |
| 9/26  | "                  | " |
| 10/3  | "                  | " |
| 10/10 | "                  | " |
| 10/17 | "                  | " |
| 10/24 | "                  | " |
| 10/31 | "                  | " |
| 11/7  | "                  | " |
| 11/14 | "                  | " |
| 11/21 | "                  | " |
| 11/28 | "                  | " |
| 12/5  | "                  | " |
| 12/12 | TD 2745            |   |
|       | 5" @ 2690          |   |
| 12/20 | "                  |   |
| 12/29 | "                  |   |
| 1946  |                    |   |
| 1/10  | Total 35,000 acid. |   |
|       | T.D. 2745'         |   |
| 1/17  | "                  | " |
| 1/24  | "                  | " |

OVER

1946

1/30 7" @ 2648

Perf.

35,000 acid.

TD 2650'

10,864,000 Gas.

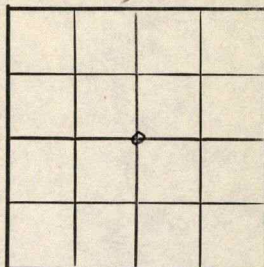
**COMPLETED**

Pool Name HugotonMap No. 11 Sec. 6 Twp. 27 R. 34WWell No. 2 CurryHelmerick & Payne

Company

**FIRST REPORT**

Contractor

C Sec**SECTION PLAT**26 40 Ft. from N. Line         Ft. from S. Line26 40 Ft. from E. Line         Ft. from W. LineHaskellLocation XRig up         

Drilling and Remarks:

**RECORD**Cased          in.,          ft.Sand         Gas         Oil         Total Depth         **PRODUCTION**1st 24 hrs. Nat.         1st 24 hrs. after shot         Gas          Cu. Ft.Dry Hole         Abandoned         

Date

DEC 6 1944 19S. J. LEWIS Scout

**KANSAS**Pool Name HugotonMap No. Norman Sec. 6 Twp. 27 R. 34WWell No. 2 CurryHelmerick & Payne Company**COMPLETED**

Contractor

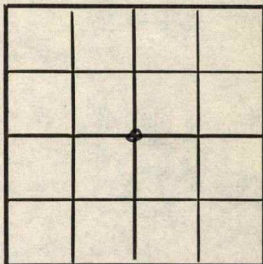
C sec.

E13005  
**SECTION PLAT**2640 Ft. from N. Line

Ft. from S. Line

2640 Ft. from E. Line

Ft. from W. Line

Haskell County

Location

Rig up

Drilling and Remarks:

7" C 2648Prof.35000 acid10,864,000 Gas**RECORD**

Cased \_\_\_\_\_ in., \_\_\_\_\_ ft.

Sand \_\_\_\_\_

Gas \_\_\_\_\_

Oil \_\_\_\_\_

Total Depth 2650**PRODUCTION**

1st 24 hrs. Nat. \_\_\_\_\_

1st 24 hrs. after shot \_\_\_\_\_

Gas \_\_\_\_\_ Cu. Ft.

Dry Hole \_\_\_\_\_

Abandoned \_\_\_\_\_

Date

JAN 30 194619S. J. LEWIS Scout