

KANSAS Haskell


Section 9
~~8~~ Township 27 Range 34W

Well No. 14
~~11~~ Jones

Company Helmerich & Payne

Hugoton Pool

NORTH

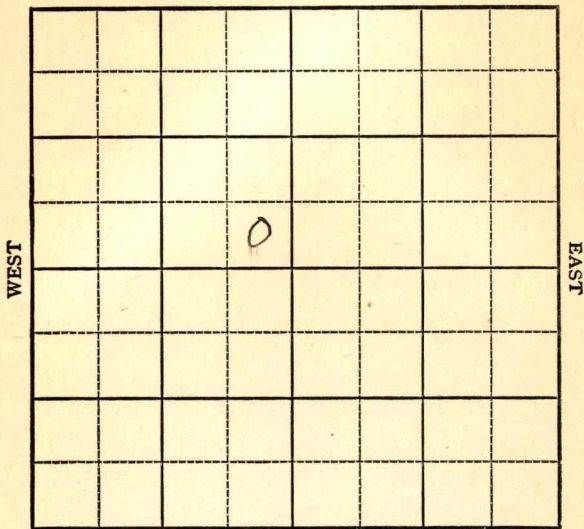

SOUTH

Haskell

Sec. 9 **KANSAS** Twp. 27 R. 34W ✓

Well No. #14 #11 Jones Farm

Helmerich & Payne Company
Hugoton Pool


 Ft. from N. Line

330' Ft. from S. Line

330' Ft. from E. Line

 Ft. from W. Line

SE NW

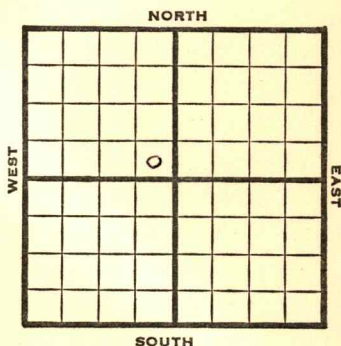

1948

Eli 2980'

R E P O R T

9/8 10" @ 522'
Drlg. 2540'

9/14 7" @ 2507'
TD 2700'
203' of 5" Perf liner @ 2700
15,000 acid

9/21 "

9/29 "

10/6 "

10/13 "

10/19 "

10/27 TD 2700'
7"@ 2507'
203' of 5" perf liner @ 2700'
15000 acid
10,852,000 Gas
397# R. Pr.
Comp

COMPLETED

Map No. _____ Sec. 9 Twp. 27 R. 34W

Well No. 14 Jones

Helmerich & Payne Company

COMPLETE

Contractor

SE NW

E. 2980

SECTION PLAT

_____ Ft. from N. Line

330

_____ Ft. from S. Line

330

_____ Ft. from E. Line

_____ Ft. from W. Line

Haskell County

RECORD

Location _____

Cased _____ in., _____ ft.

Rig up _____

Sand _____

Drilling and Remarks:

Gas _____

Oil _____

7" C2507
203' x 5" Prof line
C2700

Total Depth 2200

PRODUCTION

1st 24 hrs. Nat. _____

1st 24 hrs. after shot _____

Gas _____ Cu. Ft.

Dry Hole _____

Abandoned _____

Date

OCT 27 1948

19

S. J. LEWIS

Scout

Map No. _____ Sec. 9 Twp. 27 R. 34W

Well No. 14 Jones

Helmerich & Payne Company

CORRECTION

Contractor

SE NW


SECTION PLAT

_____ Ft. from N. Line

330 Ft. from S. Line

330 Ft. from E. Line

_____ Ft. from W. Line

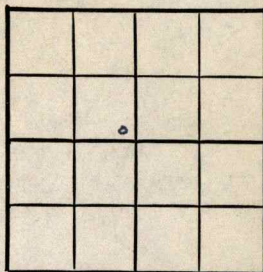

Haskell County

Location _____

Rig up _____

Drilling and Remarks:

Reported as

#11 Jones

8-27-34W

RECORD

Cased _____ in., _____ ft.

Sand _____

Gas _____

Oil _____

Total Depth _____

PRODUCTION

1st 24 hrs. Nat. _____

1st 24 hrs. after shot _____

Gas _____ Cu. Ft.

Dry Hole _____

Abandoned _____

Date

OCT 27 1948 19

S. J. LEWIS Scout

Haskell County Kansas StateMap No. _____ Sec. 8 Twp. 27 R. 34WWell No. 11 JonesHelmerich & Payne CompanyFIRST REPORT Contractor


SE NW

SECTION PLAT

_____ Ft. from N. Line

330 Ft. from S. Line330 Ft. from E. Line

_____ Ft. from W. Line

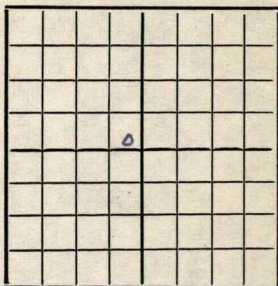Hugoton Pool

Remarks:

10" @ 522 drlg. 2540

Date
SEP 8 1948Scout
S. J. LEWIS