


O. W. P. B.

Haskell KANSAS

Section 9 Township 27 Range 34W

Well No. 17 Jones "0"

Company Helmerich & Payne

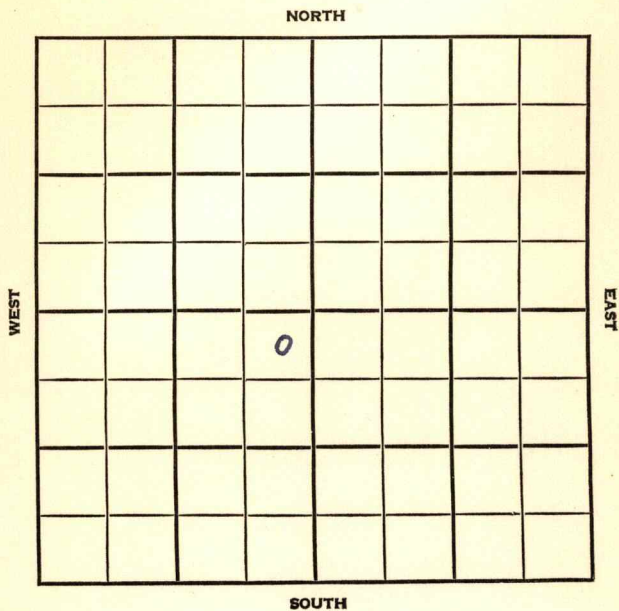

SEC.	TWP.	R.
9	27	34W

WELL NO.

#17 Jones "0"

FARM

COMPANY

Helmerich & Payne

CONTRACTOR

Co. Tools.


Pleasant Prairie NORTH

330 Ft. from N. Line

Ft. from S. Line

330 Ft. from E. Line

Ft. from W. Line

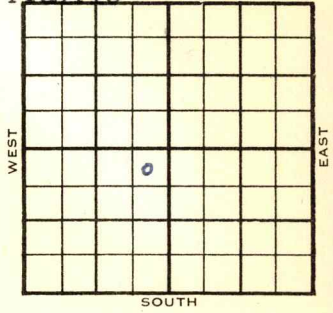

NE NE SW

ELEVATION

REPORT

1954 ~~2991'~~ - 2987' DF

11/17

Spud 10-26-54
 10" @ 544'
 Top 3410', Heeb 3860',
 DST 3610'-60' rec 1440' s.w. 900#
 KC 3887'
 DST 3882'-3900' opn 35 min, rec 540'
 S.W. 1040# Cherokee 4640'
 Drlg. 4816'

2/16

Spud 10-26-54 - Oil Well
 TD 6260'
 10" @ 544'
 Top. 3410', Heeb. 3860'
 DST 3610-60', rec. 1440' SW, 900#
 KC 3887'
 DST 3882-3900', opn 35", rec. 540'
 sw, 1040#
 Cherokee 4640', Miss. 5021'
 DST 5030-71', opn 1 hr., rec. 400'
 o&gcm, 50' free oil, 750#
 DST 5092-5132', opn 1 hr., gas in 45",
 rec. 420' free oil, 180' o&gcm, 1510#
 DST 5298-5312', opn 1 hr., rec. 1725'
 SW, 180' mud, 1540#
 DST 5462-86', opn 1 hr., rec. 120' mud,
 1400#

OVER

(Information Brought Forward)

1955
2/16

B. Miss. 5980', Chattanooga 5954',
 Misener 5960', Sylvan 5964', Viola
 5967', Simp. 5970', B. Miss. 5980',
 Arb. 6060'
 DST 6075-6100', opn 1 hr., rec. 90'
 mud, 1438#
 TD 6260'
 7" @ 5187'
 112/5096-5122', 3/4 boph frac
 6000A,
 5/13 boph
 Sch Tops: Heeb. 3853', Lans. 3892',
 Cherokee 4640', Morrow 4870', Miss.
 5005', Viola 5934', Simp. 5970',
 Arb. 6055'
 TD 6260'
 P/199 bo 24 hrs., P/ 189 bopd
 Comp. 192 bopd

COMPLETED

O. W. P. B.

1955
7/27

7" @ 5187 CO 112/4936-50 frac.
 SI 72 hr. 26 MCFG Sq. WOC
 Log: H. 3853', L. 3892',
 Cherokee 4640', Morrow 4870',
 Miss 5005', V. 5934', S. 5970'
 A. 6055'

8/10 7" @ 5187 CO 112/4936-50 frac

H 3853
 L 3892
 KC Cherokee 4640
 Morrow 4870
 Miss 5005
 V 5934
 S 5970
 a 6055

SI 72 hrs 26,000,000 cfg blow 36 hr.
 27,000,000 cfg plus 8 to 10 bbl sul.
 wtr. CO Comp 150 to 200 bopd
 Fluid level est 2700'

COMPLETED

OWPB

County Haskell Elev. 2987
 Sec. 9 Twp. 27 Rge. 34W
 Company Helmerich & Payne
 Farm Name Jones "O" No. 17

TOPS	DEPTH	LOG	DATUM
Anh.			
Tp.			
H.		<u>3853</u>	<u>866</u>
Tr.			
Dg.			
Bl.			
L.		<u>3892</u>	<u>905</u>
K.C. <u>Cherokee</u>		<u>4640</u>	<u>1653</u>
B.K.C.			
Ce.			
C.			
K.			
Mz.			
Mq.			
V.		<u>5934</u>	<u>2947</u>
S.		<u>5970</u>	<u>2983</u>
S.			
A.		<u>6055</u>	<u>3068</u>
R.			
Pf.			
G.			
T.D.			

Loc. in Sec. NE NE SW
 Geol. _____
 Contr. _____
 Pool _____
 Pleasant Prairie

COMPLETE
 0
 AUG 10 1954

Date Comm. 7" @ 5187 CO 112/1936-50 frac
SI 72 hr. 26,000,000 cfg Blow 36 hr.
27,000,000 cfg plus 8 to 10 bbl sul.
wtr. CO. Comp. 150 to 200 bopd
Fluid level est 2700'

Co.
 Lse.
 No.
 Sec.
 T.
 R.

O. W. P. B.

FORM 513 REV. SUNRAY

O.W.P.B.

County Haskell Elev. 2987
 Sec. 9 Twp. 27 Rge. 34W
 Company Helmerich & Payne
 Farm Name Jones "0" No. 17

TOPS	DEPTH	LOG	DATUM
------	-------	-----	-------

Anh.			
TP.			
H.		3853	
Tr.			
Dg.			
Bl.			
L.		3892	
K.C. Cherokee		4640	
B.K.C.			
Ce.			
C.			
M. ORROW		4870	
M. ISS		5005	
K.			
Mz.			
Mq.			
V.		5934	
S.		5970	
S.			
A.		6055	
R.			
PE.			
G.			
T.D.			

Loc. in Sec. NE NE SW
 Geol. _____
 Contr. _____
 Pool Pleasant Prairie

EXPOSURE REPORT
 0
 JUL 27 '55

Date Comm. 7" @ 5187 CO 112/4936-50 frac
SI 72 hr. 26 mcfg sq. WOC

~~25~~

Co.

Lse.

No.

Sec.

T.

R.

Drlg. Data

open 1 hr. Rec. 90' mud 1438#

TD 6260 7" @ 5187 ~~112/ 5096 5122~~

3/4 boph frac 6000 A S/ 13 boph

SCHLUMBERGER TOPS:

Heeb. 3853 ~~Lans. 3892~~ Cherokee 4640

Morrow 4870 ~~Misc. 5005~~ Viola 5934

Simp. 5970 Arb. 6055 TD 6260

P/ 199 bo 24 hr. P/ 189 bopd

Comp. 192 bopd

FEB 21 1955

Pierce Map
France Map
Lans. Map
Scott's Cards