


KANSAS Haskell

Section 7 Township 27 Range 34W

Well No. 13 Jones

Company Helmerich & Payne

Hugoton Pool
NORTH

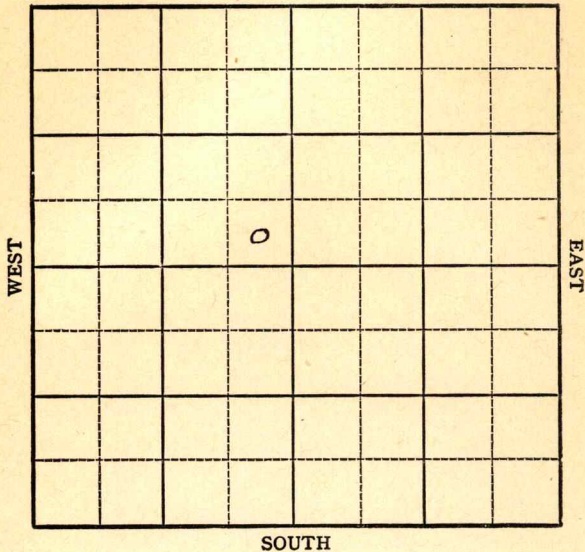

KANSAS

Haskell

Sec. 7 Twp. 27 R. 34W ✓

Well No. #13 Jones Farm

Helmerich & Payne

Hugoton Pool Company


 Ft. from N. Line

330' Ft. from S. Line

330' Ft. from E. Line

 Ft. from W. Line

SE NW

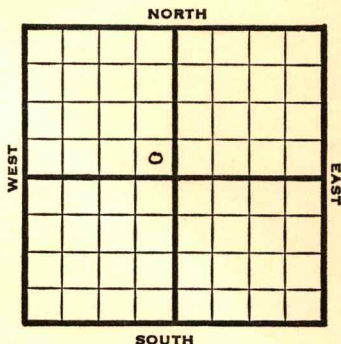

1948

Eli 2988'

R E P O R T

8/18

10" @ 539'

Drlg. 600'

8/25

Drlg 2513'

9/1

"

9/8

TD 2746'

7" @ 2559'

15000 acid

210' of 5" Perf liner @ 2746

9/15

7"@ 2559'

210' of 5" Perf Liner @ 2746' TD

15000 acid

11,796,000 gas.

402# R PR.

Comp

COMPLETED

Haskell County Kansas State

Map No. _____ Sec. 7 Twp. 27 R. 34W

Well No. 13 Jones

Helmerich & Payne Company

FIRST REPORT Contractor

SE NW

SECTION PLAT

_____ Ft. from N. Line

330 Ft. from S. Line

330 Ft. from E. Line

_____ Ft. from W. Line

Hugoton Pool

Remarks:

10" @ 539 drlg. 600

Date
AUG 18 1948

Scout

S. J. LEWIS

Haskell County Kansas State

Map No. _____ Sec. 7 Twp. 27 R. 34W

Well No. 13 Jones

Helmerich & Payne Company

COMPLETE Contractor

SE NW


E12888
SECTION PLAT

_____ Ft. from N. Line

330 Ft. from S. Line

330 Ft. from E. Line

_____ Ft. from W. Line

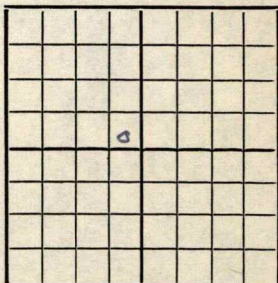

Hugoton Pool

Remarks:

7' 02559

210' x 5" Prof line @ 2746 MD

15000 acid

11,796,000 Gcs

402 # R/P

Date
SEP 15 1948

Scout
S. J. LEWIS