


DX 78-1 Haskell

KANSAS

Section 9 Township 27 Range 34W

Well No. 18 Jones "0"

Company Helmerich & Payne

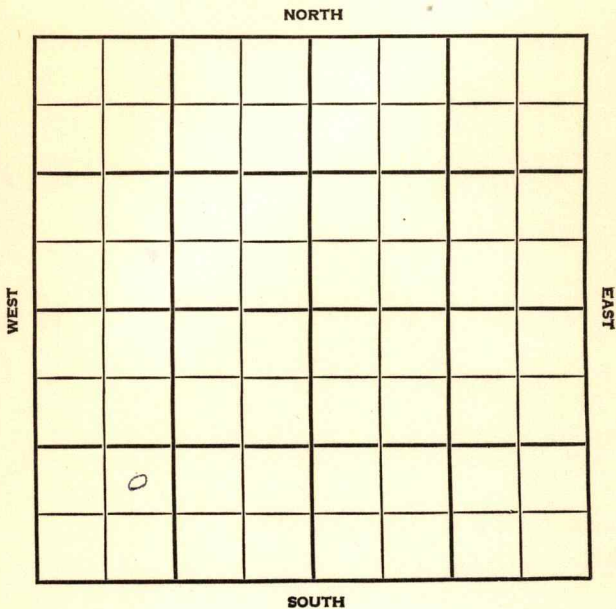

Haskell KANSAS


SEC. 9	TWP. 27	R. 34W
---------------	----------------	---------------

WELL NO. FARM
18 Jones "0"

COMPANY
Helmerich & Payne

CONTRACTOR
McKnab-Lindsay
Pleasant Prairie Pool

_____ Ft. from N. Line
 990 _____ Ft. from S. Line
 _____ Ft. from E. Line
 990 _____ Ft. from W. Line

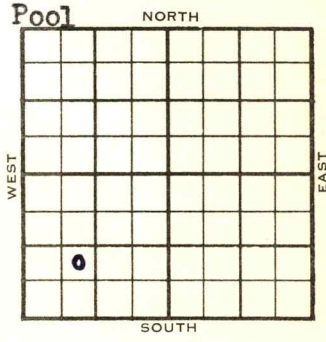

NE SW SW

1955	ELEVATION	REPORT
------	-----------	--------

4/27	MIR	Miss Test
6/29	Comm 4-28-55 H 3863, L 3904, Morrow 4932, TD 5110 10 3/4" @ 763/550 DST 4254-86 open 1 hr Rec 300' msw 1195/30" 5 1/2" @ 5109/550 DST 5085-5110 open 1 hr Rec 50' hocm, 60' free oil 100' mco 1210/20" 80/5090-5100 1/2 boph frac S/33 boph S/200 bo 6 hr P/140 bopd Comp 192 bopd	COMPLETED

County Haskell Elev. _____
 Sec. 9 Twp. 27 Rge. 34W
 Company Helmerich & Payne
 Farm Name Jones "0" No. 18

TOPS	DEPTH	LOG	DATUM	Loc. in Sec.																														
Anh.				NE SW SW																														
Tp.																																		
H.	3863																																	
Tr.				Geol. _____																														
Dg.																																		
Bl.				Contr. _____																														
L.	3904																																	
K.C.				McKnab & Lindsay																														
B.K.C.																																		
Ce.				Pool																														
C.																																		
M. <u>arrow</u>	4932			Pleasant Prairie																														
M.		5016																																
K.				<table border="1"> <tr><td></td><td></td><td></td></tr> <tr><td></td><td></td><td></td></tr> <tr><td></td><td></td><td></td></tr> <tr><td></td><td></td><td></td></tr> <tr><td></td><td></td><td></td></tr> <tr><td></td><td></td><td></td></tr> <tr><td></td><td></td><td></td></tr> <tr><td></td><td></td><td></td></tr> <tr><td></td><td></td><td></td></tr> <tr><td></td><td></td><td></td></tr> </table>																														
Mz.																																		
Mq.																																		
V.																																		
S.																																		
S.																																		
A.																																		
R.																																		
PE.																																		
G.																																		
TD.	5110																																	

Date Comm. 4-28-55 JUN 29 1955
10 3/4" @ 763/550 DST 4254-86
open 1 hr. Rec. 300' msw 1195/30"
5 1/2" @ 5109/550 DST 5085-5110 open 1 hr
Rec. 50' hocm 60' free oil 100' mco
1210/20" 80/ 5090-5100 1/2 boph
frac S/ 33 boph S/ 200 bo 6 hr.
P/ 140 bopd Comp. 192 bopd

Co.
 Sec.
 No.
 Sec.
 T.
 R.