


Section 10 Township 27 Range 34W

Well No. 12 Jones

Company Helmerich & Payne

Hugoton Pool

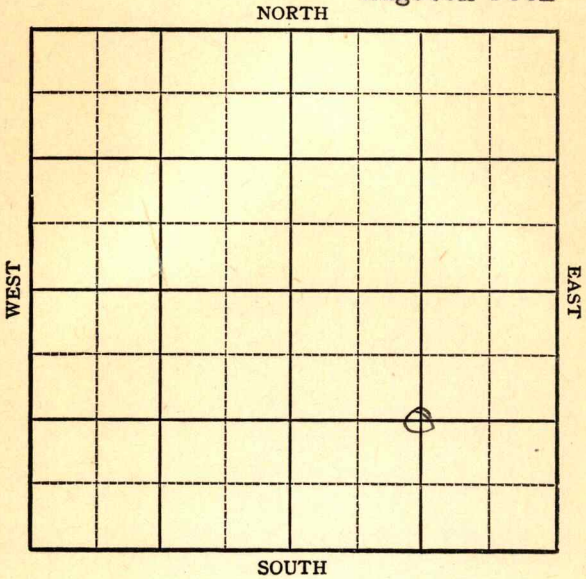

KANSAS

Haskell

Sec. 10 Twp. 27 R. 34W ✓

Well No. #12 Jones Farm

Helmerich & Payne Company

Hugoton Pool


1320' Ft. from N. Line

Ft. from S. Line

1320' Ft. from E. Line

Ft. from W. Line

C. SE

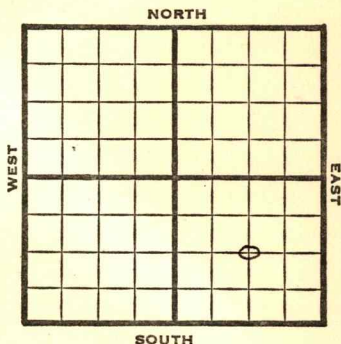

1948

Eli 2973'

REPORT

9/8 Location
9/14 10" @ 522'
TD 2561'
7" @ 2543'
9/21 "
9/29 15,000 acid
10/6 "
10/13 "
10/19 "
10/27 TD 2700'
7"@ 2543'
15000 Acid
5,382,000 Gas
402# R pr.
Comp

COMPLETED

Haskell County Kansas State

Map No. _____ Sec. 10 Twp. 27 R. 34W

Well No. 12 Jones

Helmerich & Payne Company

FIRST REPORT Contractor

C SE


SECTION PLAT

1320 Ft. from N. Line

_____ Ft. from S. Line

1320 Ft. from E. Line

_____ Ft. from W. Line

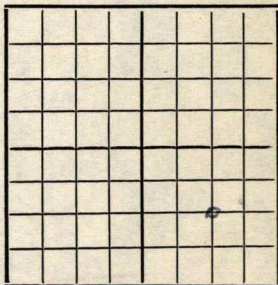

Hugoton Pool

Remarks:

Location

Date
SEP 8 1948

Scout
S. J. LEWIS

Map No. _____ Sec. 10 Twp. 27 R. 34W

Well No. 12 Jones

Helmerich & Payne Company


COMPLETE

Contractor

C SE

E. 12973

SECTION PLAT

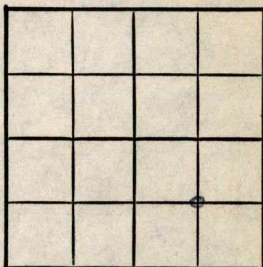

1320 Ft. from N. Line

_____ Ft. from S. Line

1320 Ft. from E. Line

_____ Ft. from W. Line

Haskell County

Location _____

Rig up _____

Drilling and Remarks:

7' @ 2548

1080 acid

5,982,000 gal

402 R/R

RECORD

Cased _____ in., _____ ft.

Sand _____

Gas _____

Oil _____

Total Depth 2700

PRODUCTION

1st 24 hrs. Nat. _____

1st 24 hrs. after shot _____

Gas _____ Cu. Ft.

Dry Hole _____

Abandoned _____

Date

OCT 27 1948

19

S. J. LEWIS

Scout