

Haskell


KANSAS

Section 11 Township 27 Range 34W

Well No. #1 Adams "F"

Company Cities Service

Hugoton Pool

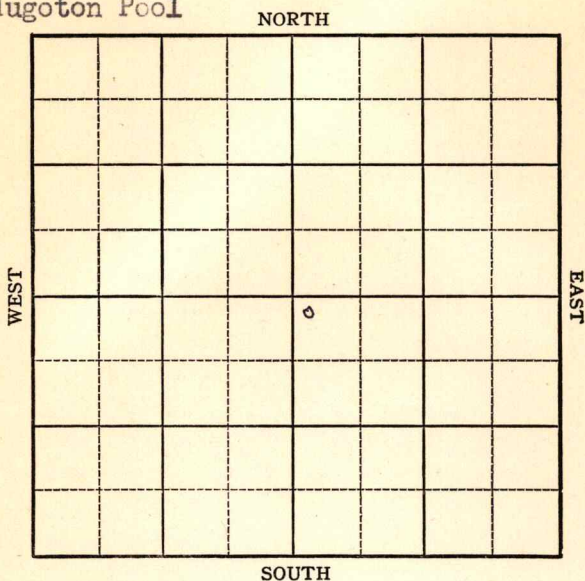

Haskell

KANSAS

Sec. 11 Twp. 27 R. 34W

Well No. #1 Adams "F" Farm

Cities Service

Hugoton Pool (Corbett & Barber, Contr.) Company


100' Ft. from N. Line

 Ft. from S. Line

 Ft. from E. Line

150' Ft. from W. Line

NW SE

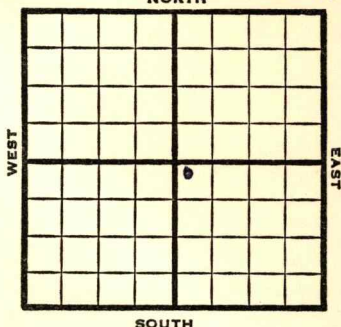

1949

Elev 2963'

REPORT

12/14

RUR

12/21

8"@ 800'

Drlg 2525'

12/28

"

1950

2/8

TD 2760'

8"@ 800'

5"@ 2759'

Win 2618'

12,100,000 CFGPD

Comp

COMPLETED

Map No. _____ Sec. 11 Twp. 27 R. 34W

Well No. 1 Adams "F"

Cities Service

Company

Corbett & Barber

Contractor

NW SE

FIRST REPORT


SECTION PLAT

100 Ft. from N. Line

_____ Ft. from S. Line

150 Ft. from E. Line

150 Ft. from W. Line

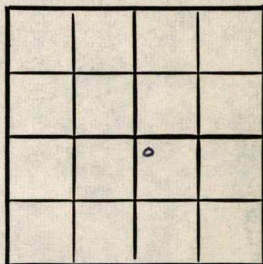

Haskell County

Location _____

Rig up _____

Drilling and Remarks:

R U R

RECORD

Cased _____ in., _____ ft.

Sand _____

Gas _____

Oil _____

Total Depth _____

PRODUCTION

1st 24 hrs. Nat. _____

1st 24 hrs. after shot _____

Gas _____ Cu. Ft.

Dry Hole _____

Abandoned _____

Date

DEC 14 1949 19

S. J. LEWIS

Scout

Kansas

Hugoton Pool

Map No. _____ Sec. 11 Twp. 27 R. 34WWell No. 1 Adams "F"

Cities Service

Company

Contractor

NW SE

E1. 2963
SECTION PLAT

		COMPLETE	
		o	

100 Ft. from N. Line

_____ Ft. from S. Line

150 Ft. from E. Line150 Ft. from W. Line
SR

Haskell County

Location _____

Rig up _____

Drilling and Remarks:

8" @ 800
 5" @ 2759
 Win - 2618
 12,100.000
 CFGPD

RECORD

Cased _____ in., _____ ft.

Sand _____

Gas _____

Oil _____

Total Depth 2760

PRODUCTION

1st 24 hrs. Nat. _____

1st 24 hrs. after shot _____

Gas _____ Cu. Ft.

Dry Hole _____

Abandoned _____

Date

FEB 8

19

19

J. E. TYRA Scout